


1 LOCATION OF WATER WELL: County: **GRAHAM** Fraction: **NW 1/4 NE 1/4 SE 1/4** Section Number: **21** Township Number: **T 7 S** Range Number: **R 25 E/W**

Distance and direction from nearest town or city street address of well if located within city?

2 WATER WELL OWNER: **Gladya Born Etal.**  
 RR#, St. Address, Box #: **Janice Goddard, (Conor.) R1 Box 158 Pender Co**  
 City, State, ZIP Code: **67659 Board of Agriculture, Division of Water Resources Application Number:**

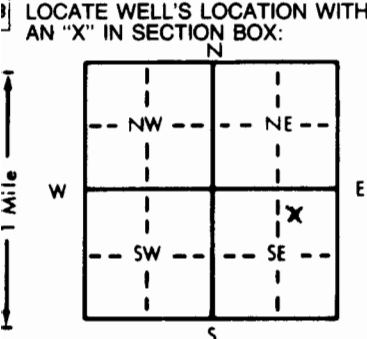

4 DEPTH OF COMPLETED WELL: \_\_\_\_\_ ft. ELEVATION: \_\_\_\_\_ ft.

Depth(s) Groundwater Encountered 1. \_\_\_\_\_ ft. 2. \_\_\_\_\_ ft. 3. \_\_\_\_\_ ft.

WELL'S STATIC WATER LEVEL \_\_\_\_\_ ft. below land surface measured on mo/day/yr \_\_\_\_\_

Pump test data: Well water was \_\_\_\_\_ ft. after \_\_\_\_\_ hours pumping \_\_\_\_\_ gpm

Est. Yield \_\_\_\_\_ gpm: Well water was \_\_\_\_\_ ft. after \_\_\_\_\_ hours pumping \_\_\_\_\_ gpm

Bore Hole Diameter \_\_\_\_\_ in. to \_\_\_\_\_ ft., and \_\_\_\_\_ in. to \_\_\_\_\_ ft.

WELL WATER TO BE USED AS:

<input type="checkbox"/> 1 Domestic	<input type="checkbox"/> 3 Feedlot	<input type="checkbox"/> 6 Oil field water supply	<input type="checkbox"/> 9 Dewatering	<input type="checkbox"/> 11 Injection well
<input type="checkbox"/> 2 Irrigation	<input type="checkbox"/> 4 Industrial	<input type="checkbox"/> 7 Lawn and garden only	<input type="checkbox"/> 10 Observation well	<input type="checkbox"/> 12 Other (Specify below)

Was a chemical/bacteriological sample submitted to Department? Yes \_\_\_\_\_ No  \_\_\_\_\_; If yes, mo/day/yr sample was submitted \_\_\_\_\_

Water Well Disinfected? Yes  No \_\_\_\_\_

5 TYPE OF BLANK CASING USED:

<input checked="" type="checkbox"/> 1 Steel	<input type="checkbox"/> 3 RMP (SR)	<input type="checkbox"/> 5 Wrought iron	<input type="checkbox"/> 8 Concrete tile	CASING JOINTS: Glued _____ Clamped _____
<input type="checkbox"/> 2 PVC	<input type="checkbox"/> 4 ABS	<input type="checkbox"/> 6 Asbestos-Cement	<input type="checkbox"/> 9 Other (specify below)	Welded _____
		<input type="checkbox"/> 7 Fiberglass		Threaded <input checked="" type="checkbox"/>

Blank casing diameter \_\_\_\_\_ in. to \_\_\_\_\_ ft., Dia \_\_\_\_\_ in. to \_\_\_\_\_ ft., Dia \_\_\_\_\_ in. to \_\_\_\_\_ ft.

Casing height above land surface \_\_\_\_\_ in., weight \_\_\_\_\_ lbs./ft. Wall thickness or gauge No. \_\_\_\_\_

TYPE OF SCREEN OR PERFORATION MATERIAL:

<input type="checkbox"/> 1 Steel	<input type="checkbox"/> 3 Stainless steel	<input type="checkbox"/> 5 Fiberglass	<input type="checkbox"/> 8 RMP (SR)	<input type="checkbox"/> 10 Asbestos-cement
<input type="checkbox"/> 2 Brass	<input type="checkbox"/> 4 Galvanized steel	<input type="checkbox"/> 6 Concrete tile	<input type="checkbox"/> 9 ABS	<input type="checkbox"/> 11 Other (specify) _____
				<input type="checkbox"/> 12 None used (open hole)

SCREEN OR PERFORATION OPENINGS ARE:

<input type="checkbox"/> 1 Continuous slot	<input type="checkbox"/> 3 Mill slot	<input type="checkbox"/> 5 Gauzed wrapped	<input type="checkbox"/> 8 Saw cut	<input type="checkbox"/> 11 None (open hole)
<input type="checkbox"/> 2 Louvered shutter	<input type="checkbox"/> 4 Key punched	<input type="checkbox"/> 6 Wire wrapped	<input type="checkbox"/> 9 Drilled holes	
		<input type="checkbox"/> 7 Torch cut	<input type="checkbox"/> 10 Other (specify) _____	

SCREEN-PERFORATED INTERVALS: From \_\_\_\_\_ ft. to \_\_\_\_\_ ft., From \_\_\_\_\_ ft. to \_\_\_\_\_ ft., From \_\_\_\_\_ ft. to \_\_\_\_\_ ft.

GRAVEL PACK INTERVALS: From \_\_\_\_\_ ft. to \_\_\_\_\_ ft., From \_\_\_\_\_ ft. to \_\_\_\_\_ ft., From \_\_\_\_\_ ft. to \_\_\_\_\_ ft.

6 GROUT MATERIAL:  1 Neat cement  2 Cement grout  3 Bentonite  4 Other \_\_\_\_\_

Grout Intervals: From \_\_\_\_\_ ft. to \_\_\_\_\_ ft., From \_\_\_\_\_ ft. to \_\_\_\_\_ ft., From \_\_\_\_\_ ft. to \_\_\_\_\_ ft.

What is the nearest source of possible contamination:

<input type="checkbox"/> 1 Septic tank	<input type="checkbox"/> 4 Lateral lines	<input type="checkbox"/> 7 Pit privy	<input type="checkbox"/> 10 Livestock pens	<input type="checkbox"/> 14 Abandoned water well
<input type="checkbox"/> 2 Sewer lines	<input type="checkbox"/> 5 Cess pool	<input type="checkbox"/> 8 Sewage lagoon	<input type="checkbox"/> 11 Fuel storage	<input type="checkbox"/> 15 Oil well/Gas well
<input type="checkbox"/> 3 Watertight sewer lines	<input type="checkbox"/> 6 Seepage pit	<input type="checkbox"/> 9 Feedyard	<input type="checkbox"/> 12 Fertilizer storage	<input type="checkbox"/> 16 Other (specify below)
			<input type="checkbox"/> 13 Insecticide storage	<b>NONE</b>

Direction from well? \_\_\_\_\_ How many feet? \_\_\_\_\_

FROM	TO	LITHOLOGIC LOG	FROM	TO	LITHOLOGIC LOG
		<b>Capped - 4" Steel Casing - 30" above ground line - Steel, screw on cap. Caulked and secured with hold down Bolts.</b>			

7 CONTRACTOR'S OR LANDOWNER'S CERTIFICATION: This water well was (1) constructed, (2) reconstructed, or (3) plugged under my jurisdiction and was completed on (mo/day/year) **12-18-87** and this record is true to the best of my knowledge and belief. Kansas Water Well Contractor's License No. \_\_\_\_\_ This Water Well Record was completed on (mo/day/yr) **12-28-87** under the business name of \_\_\_\_\_ by (signature) **Wm A Goddard**

INSTRUCTIONS: Use typewriter or ball point pen. PLEASE PRESS FIRMLY and PRINT clearly. Please fill in blanks, underline or circle the correct answers. Send top three copies to Kansas Department of Health and Environment, Bureau of Water Protection, Topeka, Kansas 66620-7320, Telephone: 913-862-9360. Send one to WATER WELL OWNER and retain one for your records.

OFFICE USE ONLY T 7 R 25 E/W SEC. 21 NW 1/4 NE 1/4 SE 1/4