

Access

LUCCERNE

USE TYPEWRITER OR BALL POINT PEN-PRESS FIRMLY, PRINT CLEARLY.


WATER WELL RECORD  
KSA 82a-1201-1215

Kansas Department of Health and Environment-Division of Environment  
(Water well Contractors)  
Topeka, Kansas 66620

BIDA

1. Location of well:	County: <u>Graham</u>	Fraction: <u>NE 1/4 SE 1/4 NW 1/4</u>	Section number: <u>30</u>	Township number: T <u>7</u> S R	Range number: <u>25</u> E/W
----------------------	-----------------------	---------------------------------------	---------------------------	---------------------------------	-----------------------------

2. Distance and direction from nearest town or city: Street address of well location if in city: <u>5 NIE Study</u>	3. Owner of well: <u>Werschel Dawes</u> R.R. or street: City, state, zip code: <u>Moland, Kansas 67650</u>
--	--

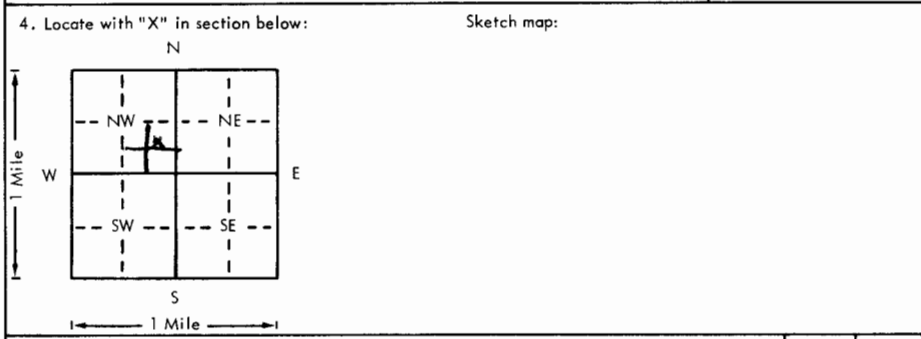

6. Bore hole dia. <u>4</u> in. Completion date <u>6-10-99</u> Well depth <u>97</u> ft.
7. <input type="checkbox"/> Cable tool <input checked="" type="checkbox"/> Rotary <input type="checkbox"/> Driven <input type="checkbox"/> Dug <input type="checkbox"/> Hollow rod <input type="checkbox"/> Jetted <input type="checkbox"/> Bored <input type="checkbox"/> Reverse rotary
8. Use: <input type="checkbox"/> Domestic <input type="checkbox"/> Public supply <input type="checkbox"/> Industry <input type="checkbox"/> Irrigation <input type="checkbox"/> Air conditioning <input checked="" type="checkbox"/> Stock <input type="checkbox"/> Lawn <input type="checkbox"/> Oil field water <input type="checkbox"/> Other
9. Casing: Material <input type="checkbox"/> Threaded <input type="checkbox"/> Welded <input type="checkbox"/> Surface <u>1 1/2</u> in. RMP <input type="checkbox"/> PVC <input checked="" type="checkbox"/> Weight <u>12</u> lbs./ft. Dia. <u>5</u> in. to <u>99</u> ft. depth Wall Thickness: inches or Dia. <u>  </u> in. to <u>  </u> ft. depth gage No. <u>200 1/4</u>

5. Type and color of material	From	To
Top soil	0	5
Sandy Clay	5	14
M gravel, gravel	14	22
Sandy Clay	22	28
Sand stone	28	32
Sandy Clay	32	40
Sand stone	40	42
Sandy Clay	42	71
M. gravel, gravel	71	96
O chie	96	97
BROCK 96'		
32		
64' sat thick		
1" Og		

10. Screen: Manufacturer's name <u>Jess Lowell</u> Type <u>PVC</u> Dia. <u>5"</u> Slot/gauze <u>1/32 1/16</u> Length <u>8'</u> Set between <u>89</u> ft. and <u>97</u> ft. Gravel pack? <input checked="" type="checkbox"/> Size range of material <u>4-1/4</u>
11. Static water level: <u>32</u> ft. below land surface Date <u>6-10-99</u> mo./day/yr.
12. Pumping level below land surfaces: <u>  </u> ft. after <u>  </u> hrs. pumping <u>  </u> g.p.m. <u>  </u> ft. after <u>  </u> hrs. pumping <u>  </u> g.p.m. Estimated maximum yield <u>30</u> g.p.m.
13. Water sample submitted: <u>  </u> mo./day/yr. <input type="checkbox"/> Yes <input checked="" type="checkbox"/> No Date <u>  </u>
14. Well head completion: <input type="checkbox"/> Pitless adapter <u>  </u> Inches above grade
15. Well grouted? <input checked="" type="checkbox"/> With: <input checked="" type="checkbox"/> Neat cement <input type="checkbox"/> Bentonite <input type="checkbox"/> Concrete Depth: From <u>0</u> ft. to <u>10</u> ft.
16. Nearest source of possible contamination: ft. <u>200</u> Direction <u>S</u> Type <u>CRICK</u> Well disinfected upon completion? <input checked="" type="checkbox"/> Yes <input type="checkbox"/> No
17. Pump: <input checked="" type="checkbox"/> Not installed Manufacturer's name <u>  </u> Model number <u>  </u> HP <u>  </u> Volts <u>  </u> Length of drop pipe <u>  </u> ft., capacity <u>  </u> g.p.m. Type: <input type="checkbox"/> Submersible <input type="checkbox"/> Turbine <input type="checkbox"/> Jet <input type="checkbox"/> Reciprocating <input type="checkbox"/> Centrifugal <u>M/T</u> Other

18. Elevation:	19. Remarks: <u>Former finished own well</u> <u>530 Top Topo</u> <u>76</u> <u>2434</u>
----------------	--

20. Water well contractor's certification: This well was drilled under my jurisdiction and this report is true to the best of my knowledge and belief. <u>B+B Drilling</u> <u>376</u> Business name License No. Address <u>Huggett, Kansas</u> Signed <u>Joseph Beckman</u> Date <u>2-5-98</u> Authorized representative
--

7 25 W 30 N E S E A W