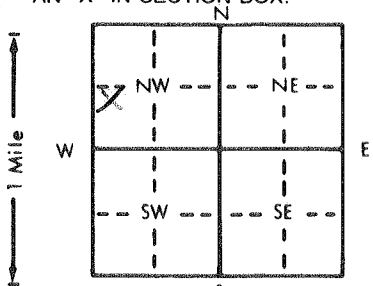


1 LOCATION OF WATER WELL: Fraction NW 1/4 SW 1/4 NW 1/4 Section Number 30 Township Number T 7 S Range Number R 26 EW
 County: Sheridan

Distance and direction from nearest town or city street address of well if located within city?

2 WATER WELL OWNER: Mike Schamberger
 RR#, St. Address, Box #: 1541 King Board of Agriculture, Division of Water Resources
 City, State, ZIP Code: Hoxie, Ks. 67740 Application Number:

3 LOCATE WELL'S LOCATION WITH AN "X" IN SECTION BOX:

 4 DEPTH OF COMPLETED WELL: 200 ft. ELEVATION:
 Depth(s) Groundwater Encountered 1. 147 ft. 2. ft. 3. ft.
 WELL'S STATIC WATER LEVEL: 147 ft. below land surface measured on mo/day/yr
 Pump test data: Well water was ft. after hours pumping gpm
 Est. Yield gpm: Well water was ft. after hours pumping gpm
 Bore Hole Diameter: 8 in. to 200 ft., and in. to ft.
 WELL WATER TO BE USED AS:
 1 Domestic 3 Feedlot 6 Oil field water supply 9 Dewatering 12 Other (Specify below)
 2 Irrigation 4 Industrial 7 Lawn and garden only 10 Monitoring well
 Was a chemical/bacteriological sample submitted to Department? Yes No X; If yes, mo/day/yr sample was submitted Water Well Disinfected? Yes No X

5 TYPE OF BLANK CASING USED:
 1 Steel 3 RMP (SR) 5 Wrought iron 8 Concrete tile CASING JOINTS: Glued X Clamped
 2 PVC 4 ABS 6 Asbestos-Cement 9 Other (specify below) Welded
 7 Fiberglass Threaded
 Blank casing diameter: 4.5 in. to 160 ft., Dia. in. to ft., Dia. in. to ft.
 Casing height above land surface: 18 in., weight 2.38 lbs./ft. Wall thickness or gauge No. 248
 TYPE OF SCREEN OR PERFORATION MATERIAL:
 1 Steel 3 Stainless steel 5 Fiberglass 8 RMP (SR) 10 Asbestos-cement
 2 Brass 4 Galvanized steel 6 Concrete tile 9 ABS 12 None used (open hole)
 SCREEN OR PERFORATION OPENINGS ARE:
 1 Continuous slot 3 Mill slot 5 Gauzed wrapped 8 Saw cut 11 None (open hole)
 2 Louvered shutter 4 Key punched 6 Wire wrapped 9 Drilled holes
 7 Torch cut 10 Other (specify)
 SCREEN-PERFORATED INTERVALS: From 160 ft. to 200 ft., From ft. to ft.
 From ft. to ft., From ft. to ft.
 GRAVEL PACK INTERVALS: From 20 ft. to 200 ft., From ft. to ft.
 From ft. to ft., From ft. to ft.

6 GROUT MATERIAL: 1 Neat cement 2 Cement grout 3 Bentonite 4 Other
 Grout Intervals: From 0 ft. to 20 ft., From ft. to ft., From ft. to ft.
 What is the nearest source of possible contamination:
 1 Septic tank 4 Lateral lines 7 Pit privy 10 Livestock pens 14 Abandoned water well
 2 Sewer lines 5 Cess pool 8 Sewage lagoon 11 Fuel storage 15 Oil well/Gas well
 3 Watertight sewer lines 6 Seepage pit 9 Feedyard 12 Fertilizer storage 16 Other (specify below)
 13 Insecticide storage
 Direction from well? How many feet?

| FROM | TO | LITHOLOGIC LOG | FROM | TO | PLUGGING INTERVALS |
|------|-----|-----------------------------|------|-----|-----------------------|
| 0 | 2 | Surface | 170 | 192 | Med. Sand/Clay Lenses |
| 2 | 14 | Loess | 192 | 195 | Clay |
| 14 | 55 | Sand, Clay & Caliche Strks. | 195 | 200 | Med. Sand & Gravel |
| 55 | 72 | Clay, Caliche & Sand Strks. | | | |
| 72 | 82 | Med. To Coarse Sand | | | |
| 82 | 95 | Clay, Caliche & Sand Strks. | | | |
| 95 | 105 | Med. Sand w/Clay Lenses | | | |
| 105 | 113 | Caliche, Clay & Sand Lenses | | | |
| 113 | 123 | Clay & Sand Strks. | | | |
| 123 | 125 | Tight Sand | | | |
| 125 | 132 | Clay & Caliche | | | |
| 132 | 142 | Med. Sand | | | |
| 142 | 147 | Clay & Caliche | | | |
| 147 | 150 | Sand | | | |
| 150 | 170 | Clay, Caliche & Sand Strks. | | | |

7 CONTRACTOR'S OR LANDOWNER'S CERTIFICATION: This water well was (1) constructed, (2) reconstructed, or (3) plugged under my jurisdiction and was completed on (mo/day/year) 12-27-96 and this record is true to the best of my knowledge and belief. Kansas Water Well Contractor's License No. 554. This Water Well Record was completed on (mo/day/yr) 1-2-97 under the business name of Woofter Pump & Well, Inc. by (signature) gray c. woofter