

LUCERNE

USE TYPEWRITER OR BALL POINT PEN-PRESS FIRMLY, PRINT CLEARLY.

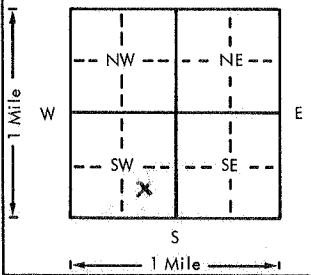
WATER WELL RECORD  
KSA 82a-1201-1215

Kansas Department of Health and Environment-Division of Environment  
(Water well Contractors)  
Topeka, Kansas 66620

CSB

1. Location of well: County SHERIDAN Fraction SE 1/4 NW 1/4 SW 1/4 Section number 10 Township number T 7 S R 26 E/W Range number

2. Distance and direction from nearest town or city: 10 N. 3. Owner of well: Alfred Duto  
Street address of well location if in city: STUDLEY R.R. or street:  
City, state, zip code: Studley, Kansas 67759

4. Locate with "X" in section below: Sketch map: 

6. Bore hole dia. 20 in. Completion date 5-76  
Well depth 215 ft.

7.  Cable tool  Rotary  Driven  Dug  
 Hollow rod  Jetted  Bored  Reverse rotary

8. Use:  Domestic  Public supply  Industry  
 Irrigation  Air conditioning  Stock  
 Lawn  Oil field water  Other

9. Casing: Material Steel Height: 0 Above or below  
Threaded  Welded  Surface 12 in.  
RMP  PVC  Weight  lbs./ft.  
Dia. 12 in. to 215 ft. depth Wall Thickness: inches or  
Dia.  in. to  ft. depth gage No. 159

5. Type and color of material	From	To
<u>Top Soil</u>	<u>0</u>	<u>115</u>
<u>Fine sand med gravel sandy clay sand stone</u> (Struck) (Struck)	<u>115</u>	<u>135</u>
<u>" " " "</u>	<u>135</u>	<u>145</u>
<u>" " " loose</u>	<u>145</u>	<u>155</u>
<u>" " " loose color</u>	<u>155</u>	<u>165</u>
<u>" " sandy clay</u>	<u>165</u>	<u>175</u>
<u>" " loose colored</u>	<u>175</u>	<u>185</u>
<u>" " " "</u>	<u>185</u>	<u>190</u>
<u>" " sandy clay sand stone</u> (Struck)	<u>190</u>	<u>195</u>
<u>" " " "</u>	<u>195</u>	<u>205</u>
<u>" " " "</u>	<u>205</u>	<u>211</u>
<u>Chert Shale</u>	<u>211</u>	<u>215</u>
<u>BROCK 211</u>		

10. Screens: Manufacturer's name W. A. Brown  
Type Ruven Dia. 12 3/4  
Slot/gauze 7/8 Length 60  
Set between 155 ft. and 215 ft.  
Gravel pack? yes Size range of material 1/4 x 3/8

11. Static water level: 126 ft. below land surface Date 3-24-76 mo./day/yr.

12. Pumping level below land surfaces:  
213 ft. after 6 hrs. pumping 1250 g.p.m.  
ft. after     hrs. pumping     g.p.m.  
Estimated maximum yield 1250 g.p.m.

13. Water sample submitted:     mo./day/yr.  
 Yes  No Date    

14. Well head completion:  
 Pitless adapter 12 Inches above grade

15. Well grouted? yes  
With:  Neat cement  Bentonite  Concrete  
Depth: From 0 ft. to 10 ft.

16. Nearest source of possible contamination:  
ft.     Direction     Type NONE  
Well disinfected upon completion?  Yes  No

17. Pump:  Not installed  
Manufacturer's name Beuhls  
Model number 8X16 1/2 HP 60 Volts      
Length of drop pipe 200 ft. capacity 900 g.p.m.  
Type:  
 Submersible  Turbine  
 Jet  Reciprocating  
 Centrifugal  Other

18. Elevation: 2592 (TOPO)  
Topography:  Hill  Slope  Upland  Valley

19. Remarks: 2592 (TOPO)

20. Water well contractor's certification:  
This well was drilled under my jurisdiction and this report is true to the best of my knowledge and belief.  
Business name Blue Jay Drilling Co. Inc. License No. 214  
Address Colby Kansas  
Signed Marilyn Rall Date 6-15-76  
Authorized representative

7 26 10 SE NW SW  
1/4 1/4 1/4 1/4

Forward the white, blue and pink copies to the Department of Health and Environment

Form WWC-5