


1 LOCATION OF WATER WELL: Fraction NW 1/4 NW 1/4 NE 1/4 Section Number 20 Township Number T 7 S Range Number R 26

County: Sheridan Distance and direction from nearest town or city street address of well if located within city?  
6north 10 1/2 east of Hoxie, Ks.

2 WATER WELL OWNER: Duane Wente  
RR#, St. Address, Box # : RT. 1 Box 74A Board of Agriculture, Division of Water Resources  
City, State, ZIP Code : Studley, Ks. 67759 Application Number: 39566

3 LOCATE WELL'S LOCATION WITH AN "X" IN SECTION BOX:

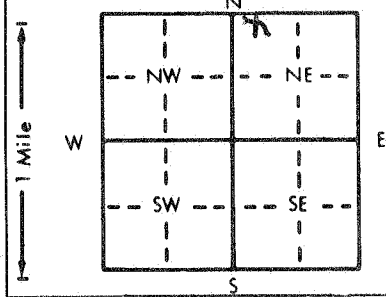

4 DEPTH OF COMPLETED WELL... 205 ft. ELEVATION:  
Depth(s) Groundwater Encountered 1. ... ft. 2. ... ft. 3. ... ft.  
WELL'S STATIC WATER LEVEL... 110 ft. below land surface measured on mo/day/yr  
Pump test data: Well water was ... ft. after ... hours pumping ... gpm  
Est. Yield ... gpm: Well water was ... ft. after ... hours pumping ... gpm  
Bore Hole Diameter... 2.8 in. to 205 ft. and ... in. to ... ft.  
WELL WATER TO BE USED AS: 5 Public water supply 8 Air conditioning 11 Injection well  
1 Domestic 3 Feedlot 6 Oil field water supply 9 Dewatering 12 Other (Specify below)  
2 Irrigation 4 Industrial 7 Lawn and garden only 10 Monitoring well  
Was a chemical/bacteriological sample submitted to Department? Yes... No... X...; If yes, mo/day/yr sample was submitted  
Water Well Disinfected? Yes No X

5 TYPE OF CASING USED: 5 Wrought iron 8 Concrete tile CASING JOINTS: Glued X Clamped  
1 Steel 3 RMP (SR) 6 Asbestos-Cement 9 Other (specify below) Welded  
2 PVC 4 ABS 7 Fiberglass Threaded

Blank casing diameter... 16 in. to 145 ft. Dia... in. to ... ft. Dia... in. to ... ft.  
Casing height above land surface... 24 in., weight... 15.54 lbs./ft. Wall thickness or gauge No. ... 500

TYPE OF SCREEN OR PERFORATION MATERIAL: 7 PVC 10 Asbestos-cement  
1 Steel 3 Stainless steel 5 Fiberglass 8 RMP (SR) 11 Other (specify)  
2 Brass 4 Galvanized steel 6 Concrete tile 9 ABS 12 None used (open hole)

SCREEN OR PERFORATION OPENINGS ARE: 5 Gauzed wrapped 8 Saw cut 11 None (open hole)  
1 Continuous slot 3 Mill slot 6 Wire wrapped 9 Drilled holes  
2 Louvered shutter 4 Key punched 7 Torch cut 10 Other (specify)

SCREEN-PERFORATED INTERVALS: From... 145 ft. to 205 ft. From ... ft. to ... ft.  
GRAVEL PACK INTERVALS: From... 20 ft. to 205 ft. From ... ft. to ... ft.

6 GROUT MATERIAL: 1 Neat cement 2 Cement grout 3 Bentonite 4 Other  
Grout Intervals: From... 0 ft. to 20 ft. From ... ft. to ... ft. From ... ft. to ... ft.

What is the nearest source of possible contamination: NONE 10 Livestock pens 14 Abandoned water well  
1 Septic tank 4 Lateral lines 7 Pit privy 11 Fuel storage 15 Oil well/Gas well  
2 Sewer lines 5 Cess pool 8 Sewage lagoon 12 Fertilizer storage 16 Other (specify below)  
3 Watertight sewer lines 6 Seepage pit 9 Feedyard 13 Insecticide storage

Direction from well? How many feet?

FROM	TO	LITHOLOGIC LOG	FROM	TO	PLUGGING INTERVALS
0	15	Surface	162	165	Clay
15	34	Sand	165	178	Sand & gravel
34	45	Clay	178	183	Clay
45	46	Caliche	183	186	Fine sand
46	75	Clay & sand streaks	186	198	Sand & gravel
75	77	Caliche	198	205	Ochre & shale
77	85	Caliche & sand streaks			
85	90	Sand			
90	91	Caliche			
91	107	Sand			
107	117	Sand with few clay streaks			
117	120	Sand & gravel with clay streaks			
120	122	Sand			
122	128	Clay & sand streaks			
128	162	Sand & gravel			

7 CONTRACTOR'S OR LANDOWNER'S CERTIFICATION: This water well was (1) constructed, (2) reconstructed, or (3) plugged under my jurisdiction and was completed on (mo/day/year) ... 2-29-92 ... and this record is true to the best of my knowledge and belief. Kansas Water Well Contractor's License No. ... 394 ... This Water Well Record was completed on (mo/day/yr) ... 3-12-92 ... under the business name of WOOFTER PUMP & WELL by (signature) *Walter Woofler*