


1] LOCATION OF WATER WELL: Fraction NE 1/4 NW 1/4 NW 1/4 Section Number 27 Township Number T 7 S Range Number R 27 W EW  
 County: Sheridan

Distance and direction from nearest town or city street address of well if located within city?

N/A - LOCATION CONFIRMED BY GMD #4

2] WATER WELL OWNER: Larry Cressler  
 RR#, St. Address, Box # : Rt 1 Box 26 Board of Agriculture, Division of Water Resources  
 City, State, ZIP Code : Hoxie, KS 67740 Application Number:

3] LOCATE WELL'S LOCATION WITH AN "X" IN SECTION BOX: 4] DEPTH OF COMPLETED WELL: UNK ft. ELEVATION: DRY  
 AN "X" IN SECTION BOX:

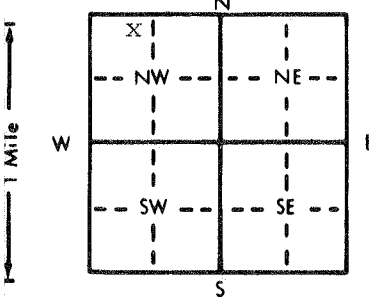

Depth(s) Groundwater Encountered 1. NA ft. 2. NA ft. 3. NA ft.  
 WELL'S STATIC WATER LEVEL NA ft. below land surface measured on mo/day/yr  
 Pump test data: Well water was NA ft. after NA hours pumping NA gpm  
 Est. Yield NA gpm: Well water was NA ft. after NA hours pumping NA gpm  
 Bore Hole Diameter NA in. to NA ft., and NA in. to NA ft.  
 WELL WATER TO BE USED AS: 5 Public water supply 8 Air conditioning 11 Injection well  
 X1 Domestic 3 Feedlot 6 Oil field water supply 9 Dewatering 12 Other (Specify below)  
 2 Irrigation 4 Industrial 7 Lawn and garden only 10 Monitoring well  
 Was a chemical/bacteriological sample submitted to Department? Yes.....No.....; If yes, mo/day/yr sample was sub-  
 mitted Water Well Disinfected? Yes No

5] TYPE OF BLANK CASING USED: 5 Wrought iron 8 Concrete tile CASING JOINTS: Glued.....Clamped.....  
 X1 Steel 3 RMP (SR) 6 Asbestos-Cement 9 Other (specify below) Welded.....  
 2 PVC 4 ABS 7 Fiberglass Threaded.....

Blank casing diameter .5 in. to NA ft., Dia. NA in. to NA ft., Dia. NA in. to NA ft.  
 Casing height above land surface 12 in., weight NA lbs./ft. Wall thickness or gauge No. NA

TYPE OF SCREEN OR PERFORATION MATERIAL: 7 PVC 10 Asbestos-cement  
 1 Steel 3 Stainless steel 5 Fiberglass 8 RMP (SR) 11 Other (specify).....  
 2 Brass 4 Galvanized steel 6 Concrete tile 9 ABS 12 None used (open hole)

SCREEN OR PERFORATION OPENINGS ARE: 5 Gauzed wrapped 8 Saw cut 11 None (open hole)  
 1 Continuous slot 3 Mill slot 6 Wire wrapped 9 Drilled holes  
 2 Louvered shutter 4 Key punched 7 Torch cut 10 Other (specify).....

SCREEN-PERFORATED INTERVALS: From NA ft. to NA ft., From NA ft. to NA ft., From NA ft. to NA ft.  
 GRAVEL PACK INTERVALS: From NA ft. to NA ft., From NA ft. to NA ft., From NA ft. to NA ft.

6] GROUT MATERIAL: 1 Neat cement 2 Cement grout 3 Bentonite 4 Other.....  
 Grout Intervals: From 6 ft. to 7 ft., From NA ft. to NA ft., From NA ft. to NA ft., From NA ft. to NA ft.

What is the nearest source of possible contamination: NONE  
 1 Septic tank 4 Lateral lines 7 Pit privy 10 Livestock pens 14 Abandoned water well  
 2 Sewer lines 5 Cess pool 8 Sewage lagoon 11 Fuel storage 15 Oil well/Gas well  
 3 Watertight sewer lines 6 Seepage pit 9 Feedyard 12 Fertilizer storage 16 Other (specify below)  
 13 Insecticide storage

Direction from well? How many feet?

FROM	TO	LITHOLOGIC LOG	FROM	TO	PLUGGING INTERVALS
		ENTER			
		PLUGGING			
		INFORMATION			
		AT			
		RIGHT			

RECEIVED  
 NOV 30 1989

7] CONTRACTOR'S OR LANDOWNER'S CERTIFICATION: This water well was (1) constructed, (2) reconstructed, or (3) plugged under my jurisdiction and was completed on (mo/day/year) 11-15-89 and this record is true to the best of my knowledge and belief. Kansas Water Well Contractor's License No. NA This Water Well Record was completed on (mo/day/yr) 11-15-89 under the business name of NA by (signature) Larry Cressler