


1 LOCATION OF WATER WELL: County: Sheridan Fraction: NE 1/4 SW 1/4 E SW 1/4 Section Number: 09 Township Number: T 7 S Range Number: R 27 E/W

Distance and direction from nearest town or city street address of well if located within city?
4 Miles North 4 East of Hoxie, Kansas

2 WATER WELL OWNER: William Richardson
 RR#, St. Address, Box #: 701 15th St. Board of Agriculture, Division of Water Resources
 City, State, ZIP Code: Hoxie, Ks. 67740 Application Number:

3 LOCATE WELL'S LOCATION WITH AN "X" IN SECTION BOX:

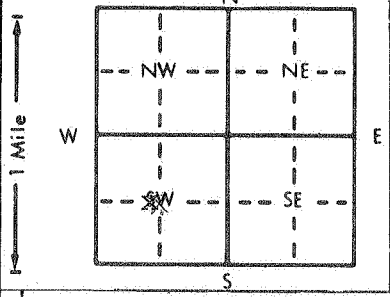

4 DEPTH OF COMPLETED WELL: 187 ft. ELEVATION:

Depth(s) Groundwater Encountered 1. ft. 2. ft. 3. ft.
 WELL'S STATIC WATER LEVEL ... 120 ft. below land surface measured on mo/day/yr ... 4-24-89
 Pump test data: Well water was ft. after hours pumping gpm
 Est. Yield gpm: Well water was ft. after hours pumping gpm
 Bore Hole Diameter ... 9 in. to ... 187 ft., and ... in. to ... ft.
 WELL WATER TO BE USED AS: 5 Public water supply 8 Air conditioning 11 Injection well
 ① Domestic 3 Feedlot 6 Oil field water supply 9 Dewatering 12 Other (Specify below)
 2 Irrigation 4 Industrial 7 Lawn and garden only 10 Monitoring well ... Stockwell
 Was a chemical/bacteriological sample submitted to Department? Yes.....No...X.....; If yes, mo/day/yr sample was submitted
 Water Well Disinfected? Yes No X

5 TYPE OF BLANK CASING USED: 5 Wrought iron 8 Concrete tile CASING JOINTS: Glued X ... Clamped ...
 1 Steel 3 RMP (SR) 6 Asbestos-Cement 9 Other (specify below) Welded ...
 2 PVC 4 ABS 7 Fiberglass Threaded ...

Blank casing diameter ... 4.5 in. to ... 167 ft., Dia ... in. to ... ft., Dia ... in. to ... ft.
 Casing height above land surface ... 12 in., weight ... 2.384 lbs./ft. Wall thickness or gauge No. ... 0.248

TYPE OF SCREEN OR PERFORATION MATERIAL: 7 PVC 10 Asbestos-cement
 1 Steel 3 Stainless steel 5 Fiberglass 8 RMP (SR) 11 Other (specify) ...
 2 Brass 4 Galvanized steel 6 Concrete tile 9 ABS 12 None used (open hole)

SCREEN OR PERFORATION OPENINGS ARE: 5 Gauzed wrapped 8 Saw cut 11 None (open hole)
 1 Continuous slot 3 Mill slot 6 Wire wrapped 9 Drilled holes
 2 Louvered shutter 4 Key punched 7 Torch cut 10 Other (specify) ...

SCREEN-PERFORATED INTERVALS: From ... 167 ft. to ... 187 ft., From ... ft. to ... ft.
 GRAVEL PACK INTERVALS: From ... 20 ft. to ... 167 ft., From ... ft. to ... ft.

6 GROUT MATERIAL: 1 Neat cement 2 Cement grout 3 Bentonite 4 Other ...
 Grout Intervals: From ... 0 ft. to ... 20 ft., From ... ft. to ... ft., From ... ft. to ... ft.

What is the nearest source of possible contamination:
 1 Septic tank 4 Lateral lines 7 Pit privy 10 Livestock pens 14 Abandoned water well
 2 Sewer lines 5 Cess pool 8 Sewage lagoon 11 Fuel storage 15 Oil well/Gas well
 3 Watertight sewer lines 6 Seepage pit 9 Feedyard 12 Fertilizer storage 16 Other (specify below)
 13 Insecticide storage
 Direction from well? West How many feet? 1250

FROM	TO	LITHOLOGIC LOG	FROM	TO	PLUGGING INTERVALS
0	15	Clay	102	107	Clay & Caliche
15	25	Clay	107	110	Med Hard Caliche
25	26	Caliche	110	118	Caliche & Sand Strks Med Sand
26	30	Clay	118	120	Hard Caliche very Sandstone
30	35	sandy Clay	120	122	Med hard Sandstone
35	39	Sand	122	132	6' Med Sand
39	44	Caliche	132	137	Hard Streaks, Med Sand
44	46	Sand	137	138	Clay
46	62	Sandy Clay w/sand streaks	138	152	Med sand w/thin clay strks.
62	68	Sandy Clay	152	154	Sandy Clay
68	70	Hard Caliche	154	181	Med Sand & Gravel
70	72	Clay	181	187	Shale
72	74	Sand & Caliche (Hard)			
74	96	Clay & sandy clay			
96	102	Med Sand			

7 CONTRACTOR'S OR LANDOWNER'S CERTIFICATION: This water well was (1) constructed, (2) reconstructed, or (3) plugged under my jurisdiction and was completed on (mo/day/year) ... 4-24-89 ... and this record is true to the best of my knowledge and belief. Kansas Water Well Contractor's License No. ... 394 ... This Water Well Record was completed on (mo/day/yr) ... 4-26-89 ... under the business name of Woofter Pump & Well by (signature) Walt Wolf