

USE TYPEWRITER OR BALL POINT PEN-PRESS FIRMLY, PRINT CLEARLY.

WATER WELL RECORD
KSA 82a-1201-1215


Kansas Department of Health and Environment-Division of Environment (Water well Contractors) Topeka, Kansas 66620

Job #236-77-A-30-7-27

AAC

1. Location of well: County **Sheridan** Fraction **CENTER 1/4 NE 1/4** Section number **30** Township number **T 7 S R 27** Range number **27** W

2. Distance and direction from nearest town or city: **From Hoxie; 4 1/2 North; 3 3/4 East**
Street address of well location if in city:
3. Owner of well: **Jerry Reed**
R.R. or street:
City, state, zip code: **Hoxie, Kansas**

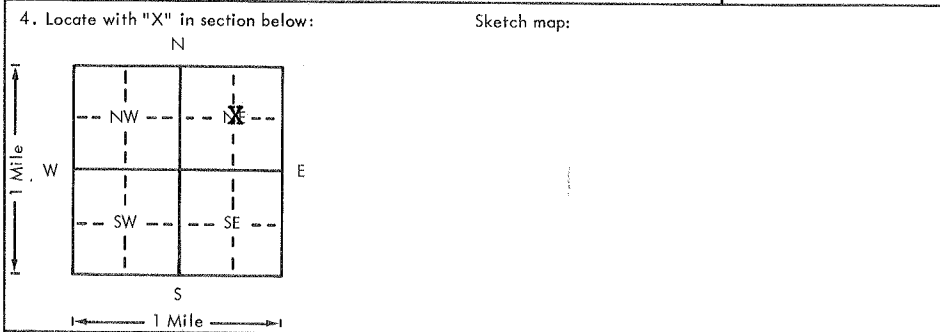

6. Bore hole dia. 30 in. Completion date 7-29-77
Well depth 194 ft.

7. Cable tool Rotary Driven Dug
 Hollow rod Jetted Bored Reverse rotary

8. Use: Domestic Public supply Industry
 Irrigation Air conditioning Stock
 Lawn Oil field water Other

9. Casing: Material Steel Height: Above ~~XXXX~~
Threaded Welded Surface 12 in.
RMP PVC Weight .188 lbs./ft.
Dia. 16 in. to 144 ft. depth Wall Thickness: inches or
Dia. in. to ft. depth gage No. #7

5. Type and color of material	From	To
Sandy Clay	0	47
Sandstone, Clay	47	70
Gravel	70	75
Sandstone, Clay	75	125
Coarse Sand, Gravel	125	150
Sandy Clay	150	156
Coarse Sand, Gravel	156	165
Sandstone, Clay	165	178
Gravel, Coarse	178	190
Shale	190	194
(Use a second sheet if needed)		

10. Screen: Manufacturer's name Brown
Type Regular Dia. 16"
Slot/gauze 10% Length 40'
Set between 144' ft. and 184' ft.
10' Cook 184' ft. and 194' ft.
Gravel pack? Size range of material 30% #170% x 5/8

11. Static water level: 131 ft. below land surface Date 7-29-77 mo./day/yr.

12. Pumping level below land surfaces:
190 ft. after 2 hrs. pumping 480 g.p.m.
190 ft. after 2 hrs. pumping 480 g.p.m.
Estimated maximum yield 480 g.p.m.

13. Water sample submitted: mo./day/yr.
 Yes No Date

14. Well head completion:
 Pitless adapter 12 Inches above grade

15. Well grouted?
With: Neat cement Bentonite Concrete
Depth: From 0 ft. to 10 ft.

16. Nearest source of possible contamination:
ft. 2000' Direction NE Type Farmstead
Well disinfected upon completion? Yes No

17. Pump: Not installed
Manufacturer's name Customers Pump
Model number HP Volts
Length of drop pipe ft. capacity g.p.m.
Type:
 Submersible Turbine
 Jet Reciprocating
 Centrifugal Other

18. Elevation:
Topography:
 Hill
 Slope
 Upland
 Valley

19. Remarks:
BROCK 190'

20. Water well contractor's certification:
This well was drilled under my jurisdiction and this report is true to the best of my knowledge and belief.
Western Well & Pump 245
Business name License No. 67701
Address Box 852, Colby, KS
Signed [Signature] Date 8/26/77
Authorized representative

T-7 270 30 CNE 1/4 1/4 1/4

Forward the white, blue and pink copies to the Department of Health and Environment

Form WWC-5