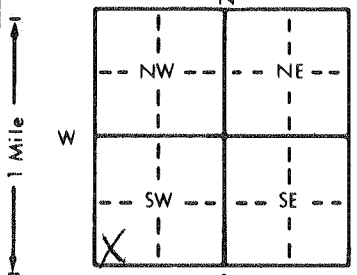


1 LOCATION OF WATER WELL: Fraction SW 1/4 SW 1/4 SW 1/4 Section Number 35 Township Number T 7 S Range Number R 28 EW
 County: Sheridan
 Distance and direction from nearest town or city street address of well if located within city?

2 WATER WELL OWNER: Al Weeks
 RR#, St. Address, Box #: Rt. 1 Box 86 Board of Agriculture, Division of Water Resource
 City, State, ZIP Code: Hoxie, Ks. 67740 Application Number:

3 LOCATE WELL'S LOCATION WITH AN "X" IN SECTION BOX:

 4 DEPTH OF COMPLETED WELL: 222 ft. ELEVATION:
 Depth(s) Groundwater Encountered 1. 168 ft. 2. ft. 3. ft.
 WELL'S STATIC WATER LEVEL: 168 ft. below land surface measured on mo/day/yr
 Pump test data: Well water was ft. after hours pumping gpm
 Est. Yield gpm: Well water was ft. after hours pumping gpm
 Bore Hole Diameter: 8 in. to 222 ft., and in. to ft.
 WELL WATER TO BE USED AS:
 1 Domestic 3 Feedlot 6 Oil field water supply 9 Dewatering 12 Other (Specify below)
 2 Irrigation 4 Industrial 7 Lawn and garden only 10 Monitoring well
 Was a chemical/bacteriological sample submitted to Department? Yes No X; If yes, mo/day/yr sample was submitted
 Water Well Disinfected? Yes No X

5 TYPE OF BLANK CASING USED:
 1 Steel 3 RMP (SR) 5 Wrought iron 8 Concrete tile CASING JOINTS: Glued X Clamped
 2 PVC 4 ABS 6 Asbestos-Cement 9 Other (specify below) Welded
 7 Fiberglass Threaded
 Blank casing diameter 4.5 in. to 182 ft., Dia in. to ft., Dia in. to ft.
 Casing height above land surface: 18 in., weight 2.38 lbs./ft. Wall thickness or gauge No. 24.8
 TYPE OF SCREEN OR PERFORATION MATERIAL:
 1 Steel 3 Stainless steel 5 Fiberglass 7 PVC 10 Asbestos-cement
 2 Brass 4 Galvanized steel 6 Concrete tile 8 RMP (SR) 11 Other (specify)
 9 ABS 12 None used (open hole)
 SCREEN OR PERFORATION OPENINGS ARE:
 1 Continuous slot 3 Mill slot 5 Gauzed wrapped 8 Saw cut 11 None (open hole)
 2 Louvered shutter 4 Key punched 6 Wire wrapped 9 Drilled holes
 7 Torch cut 10 Other (specify)
 SCREEN-PERFORATED INTERVALS: From 182 ft. to 222 ft., From ft. to ft.
 GRAVEL PACK INTERVALS: From 20 ft. to 222 ft., From ft. to ft.

6 GROUT MATERIAL: 1 Neat cement 2 Cement grout 3 Bentonite 4 Other
 Grout Intervals: From 0 ft. to 20 ft., From ft. to ft., From ft. to ft.
 What is the nearest source of possible contamination: None
 1 Septic tank 4 Lateral lines 7 Pit privy 10 Livestock pens 14 Abandoned water well
 2 Sewer lines 5 Cess pool 8 Sewage lagoon 11 Fuel storage 15 Oil well/Gas well
 3 Watertight sewer lines 6 Seepage pit 9 Feedyard 12 Fertilizer storage 16 Other (specify below)
 13 Insecticide storage

Direction from well?		LITHOLOGIC LOG		How many feet?		PLUGGING INTERVALS
FROM	TO			FROM	TO	
0	3	Surface		125	127	Sand
3	19	Loess		127	128	Hard Caliche
19	34	Clay & Silty Sand		128	134	Clay & Caliche
34	37	Fine to Med. Sand		134	158	Sandy Clay, Clay & Sand Strks
37	48	Tight Sand		158	161	Med. Sand
48	49	Caliche		161	176	Cemented Sand/Clay & Caliche
49	58	Med. Sand-Clay & Caliche Strks		176	188	Med. Sand
58	61	Clay & Sand		188	198	Sandy Clay
61	67	Med. Sand		198	200	Sand
67	87	Clay, Cemented Sand & Caliche Strks				
87	92	Med. Sand/Caliche Strks.		200	209	Sandy Clay & Clay
92	98	Med. Sand/Caliche & Clay Strks.		209	212	Med. Sand
98	116	Brown Clay & Caliche Strks.		212	215	Caliche
116	117	Rock Layer		215	218	Clay
117	125	Clay & Caliche		218	222	Med. Sand & Gravel

7 CONTRACTOR'S OR LANDOWNER'S CERTIFICATION: This water well was (1) constructed, (2) reconstructed, or (3) plugged under my jurisdiction and was completed on (mo/day/year) 9-14-95 and this record is true to the best of my knowledge and belief. Kansas Water Well Contractor's License No. 554. This Water Well Record was completed on (mo/day/yr) 9-20-95 under the business name of Woofter Pump & Well, Inc. by (signature) *James Woofter*