

1 LOCATION OF WATER WELL: Fraction SE 1/4 NE 1/4 SW 1/4 Section Number 4 Township Number T 7 S Range Number R 28 E/W
 County: Sheridan

Distance and direction from nearest town or city street address of well if located within city?

7 1/2 North of Hoxie, Kansas

2 WATER WELL OWNER: Mark Schamberger

RR#, St. Address, Box # : Rt. 2


Board of Agriculture, Division of Water Resources

City, State, ZIP Code : Hoxie, Ks. 67740

Application Number:

3 LOCATE WELL'S LOCATION WITH AN "X" IN SECTION BOX:

4 DEPTH OF COMPLETED WELL: 170' ft. ELEVATION:

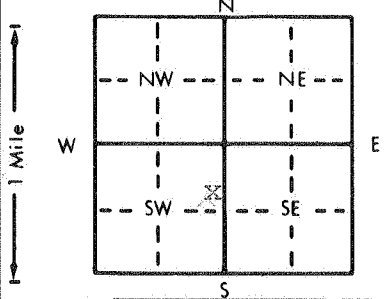

Depth(s) Groundwater Encountered 1. ft. 2. ft. 3. ft.

WELL'S STATIC WATER LEVEL 81 ft. below land surface measured on mo/day/yr 6-16-89

Pump test data: Well water was ft. after hours pumping gpm

Est. Yield gpm: Well water was ft. after hours pumping gpm

Bore Hole Diameter 9 in. to 170 ft., and in. to ft.

WELL WATER TO BE USED AS: 5 Public water supply 8 Air conditioning 11 Injection well

Domestic 3 Feedlot 6 Oil field water supply 9 Dewatering 12 Other (Specify below)

2 Irrigation 4 Industrial 7 Lawn and garden only 10 Monitoring well Stockwell

Was a chemical/bacteriological sample submitted to Department? Yes.....No.....; If yes, mo/day/yr sample was submitted Water Well Disinfected? Yes No

5 TYPE OF BLANK CASING USED:

5 Wrought iron 8 Concrete tile CASING JOINTS: Glued Clamped

1 Steel 3 RMP (SR)

6 Asbestos-Cement 9 Other (specify below) Welded

2 PVC 4 ABS

7 Fiberglass Threaded

Blank casing diameter 4.5 in. to 150 ft., Dia in. to ft., Dia in. to ft.

Casing height above land surface 18 in., weight 2.33 lbs./ft. Wall thickness or gauge No. 248

TYPE OF SCREEN OR PERFORATION MATERIAL:

7 PVC 10 Asbestos-cement

1 Steel 3 Stainless steel

8 RMP (SR) 11 Other (specify)

2 Brass 4 Galvanized steel

9 ABS 12 None used (open hole)

SCREEN OR PERFORATION OPENINGS ARE:

5 Gauzed wrapped 8 Saw cut 11 None (open hole)

1 Continuous slot 3 Mill slot

6 Wire wrapped 9 Drilled holes

2 Louvered shutter 4 Key punched

7 Torch cut 10 Other (specify)

SCREEN-PERFORATED INTERVALS: From 150 ft. to 170 ft., From ft. to ft.

GRAVEL PACK INTERVALS: From 20 ft. to 170 ft., From ft. to ft.

6 GROUT MATERIAL:

1 Neat cement 2 Cement grout 3 Bentonite 4 Other

Grout Intervals: From 0 ft. to 20 ft., From ft. to ft., From ft. to ft.

What is the nearest source of possible contamination: 10 Livestock pens 14 Abandoned water well

1 Septic tank 4 Lateral lines 7 Pit privy 11 Fuel storage 15 Oil well/Gas well

2 Sewer lines 5 Cess pool 8 Sewage lagoon 12 Fertilizer storage 16 Other (specify below)

3 Watertight sewer lines 6 Seepage pit 9 Feedyard 13 Insecticide storage

Direction from well? North How many feet? 100

FROM	TO	LITHOLOGIC LOG	FROM	TO	PLUGGING INTERVALS
0	3	Surface	161	163	Fine Sand
3	37	Clay	163	170	Ochre
37	57	Caliche & Clay			
57	64	Fine/Med. sand			
64	74	Clay			
74	94	Caliche			
94	96	Fine/Med. sand			
96	97	Caliche			
97	121	Clay			
121	127	Caliche			
127	139	Clay			
139	154	Caliche			
154	157	Fine Sand			
157	158	Clay			
158	161	Caliche			

7 CONTRACTOR'S OR LANDOWNER'S CERTIFICATION: This water well was (1) constructed, (2) reconstructed, or (3) plugged under my jurisdiction and was completed on (mo/day/year) 6-16-89 and this record is true to the best of my knowledge and belief. Kansas Water Well Contractor's License No. 394 This Water Well Record was completed on (mo/day/yr) 6-19-89 under the business name of Woofter Pump & Well Service by (signature) Walt Wraft