

USE TYPEWRITER OR BALL POINT PEN—PRESS FIRMLY, PRINT CLEARLY.

Hoxie NW

T R EW sec 1/4 1/4 1/4 No.


WATER WELL RECORD
KSA 82a-1201-1215

Kansas State Dept. Of Health
(Water Well Contractors)
Forbes-Bldg. 740
Topeka, Kansas 66620

DAA AAA

1 Location of well:	County Sheridan	Township name Parnell	Fraction NE 1/4 SE 1/4	Section number 4	Town number 7	Range number 28
---------------------	---------------------------	---------------------------------	--	----------------------------	-------------------------	---------------------------

Distance and direction from nearest town or city: Street address of well location if in city:	8 miles north of Hoxie, Kansas	3 Owner of well: Address:	Felix Schamberger Hoxie, Kansas
--	---------------------------------------	------------------------------	--

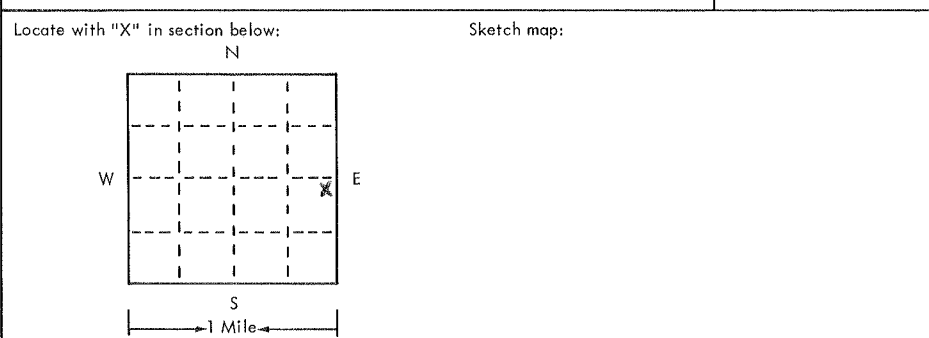

4 Well depth: 245 ft. Date of completion 3-18-75 Well diameter 12 3/4
5 <input type="checkbox"/> Cable tool <input type="checkbox"/> Rotary <input type="checkbox"/> Driven <input type="checkbox"/> Dug <input type="checkbox"/> Hollow rod <input type="checkbox"/> Jetted <input type="checkbox"/> Bored <input checked="" type="checkbox"/> Reverse rotary
6 Use: <input type="checkbox"/> Domestic <input type="checkbox"/> Public supply <input type="checkbox"/> Industry <input checked="" type="checkbox"/> Irrigation <input type="checkbox"/> Air conditioning <input type="checkbox"/> Commercial <input type="checkbox"/> Test well
7 Casing: Material steel Height: above/below Threaded <input type="checkbox"/> Welded <input checked="" type="checkbox"/> Surface 12 in. Diam. 12 3/4 Weight 33 lbs./ft. 1 0 in. to 245 ft. depth Drive shoe? <input type="checkbox"/> Yes <input checked="" type="checkbox"/> No — in. to — ft. depth

2	Type and color of material	From	To
	Top soil	0	115
	Fine sand, Med gravel red	120	134
	Fine sand, med gravel, sandy clay, sandstone	134	155
	Fine sand, med. gravel, sandy clay red	155	165
	Fine sand, sandy clay, sandstone	165	175
	Fine sand, sandy clay, rock	175	192
	Fine sand, med. gravel, bed	192	205
	Fine sand, med. gravel, sandy clay, sandstone	205	215
	Fine, sand, med. gravel,	215	218
	Fine sand, med. gravel, sandy clay, sandstone	218	222
	Fine sand, med. gravel, sandy clay, loose small	222	235
	Fine sand, med. gravel, red	235	241
	Ochre, shale	241	255
	BRICK 241'		
	(use a second sheet if needed)		

8 Screen: Manufacturer W. A. Brown Type Luver Dia. 12 3/4 Slot/gauze 7 - 1/8 Length 40 Set between 205 ft. and 245 ft. Fittings: Gravel pack <input checked="" type="checkbox"/> Yes <input type="checkbox"/> No Size range of material 1/4x5/8
9 Static water level: 122 ft. below land surface Date 1-27-75
10 Pumping level below land surfaces: 243 ft. after 8 hrs. pumping 450 g.p.m. — ft. after — hrs. pumping — g.p.m. Estimated maximum yield 450 g.p.m.
11 Water sample submitted: <input type="checkbox"/> Yes <input checked="" type="checkbox"/> No Date —
12 Well head completion: <input type="checkbox"/> Pitless adapter 12 Inches above grade
13 Well grouted? <input checked="" type="checkbox"/> Yes <input type="checkbox"/> No <input checked="" type="checkbox"/> Neat cement <input type="checkbox"/> Bentonite <input type="checkbox"/> — Depth: From 0 ft. to 10 ft.
14 Nearest source of possible contamination: ft. — Direction — Type None Well disinfected upon completion? <input type="checkbox"/> Yes <input checked="" type="checkbox"/> No
15 Pump: <input type="checkbox"/> Not installed Manufacturer's name Goulds Model number 6X16 HP 60 Volts — Length of drop pipe 235 ft. capacity 450 g.m.p. Type: <input type="checkbox"/> Submersible <input checked="" type="checkbox"/> Turbine <input type="checkbox"/> Jet <input type="checkbox"/> Reciprocating <input type="checkbox"/> Centrifugal <input type="checkbox"/> Other

16 Remarks: elevation

Topography:
 Hill
 Slope
 Upland
 Valley

2774 (TOPO)
2774

17 Water well contractor's certification:
This well was drilled under my jurisdiction and this report is true to the best of my knowledge and belief.

Blue Jay Drilling Co. Inc. License No. **214**
Business name License No.
Address **Colby, Kansas**
Signed **Marilyn Ball** Date **3-18-75**
Authorized representative