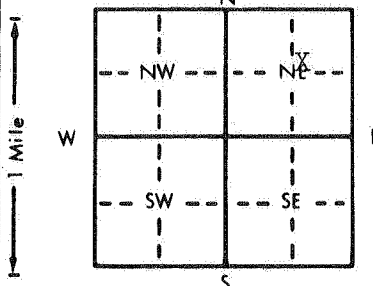


1 LOCATION OF WATER WELL: Fraction SW 1/4 NE 1/4 NE 1/4 Section Number 15 Township Number T 7 S Range Number R28 E/W
 County: Sheridan

Distance and direction from nearest town or city street address of well if located within city?
 6 North 1 East of Hoxie

2 WATER WELL OWNER: Archie, Moss
 RR#, St. Address, Box # :
 City, State, ZIP Code : Hoxie, KS 67740
 Board of Agriculture, Division of Water Resources
 Application Number: 37804

3 LOCATE WELL'S LOCATION WITH AN "X" IN SECTION BOX:

 4 DEPTH OF COMPLETED WELL: 236 ft. ELEVATION:
 Depth(s) Groundwater Encountered 1. 168 ft. 2. ft. 3. ft.
 WELL'S STATIC WATER LEVEL 168 ft. below land surface measured on mo/day/yr 7-5-86
 Pump test data: Well water was ft. after hours pumping gpm
 Est. Yield gpm: Well water was ft. after hours pumping gpm
 Bore Hole Diameter 28 in. to 236 ft., and in. to ft.
 WELL WATER TO BE USED AS:
 1 Domestic 3 Feedlot 6 Oil field water supply 9 Dewatering 12 Other (Specify below)
 2 Irrigation 4 Industrial 7 Lawn and garden only 10 Observation well
 Was a chemical/bacteriological sample submitted to Department? Yes.....No.....; If yes, mo/day/yr sample was submitted
 Water Well Disinfected? Yes No

5 TYPE OF BLANK CASING USED:
 1 Steel 3 RMP (SR) 5 Wrought iron 8 Concrete tile CASING JOINTS: Glued Clamped
 2 PVC 4 ABS 6 Asbestos-Cement 9 Other (specify below) Welded X
 7 Fiberglass Threaded
 Blank casing diameter 16 in. to ft., Dia in. to ft., Dia in. to ft.
 Casing height above land surface 20 in., weight 36.87 lbs./ft. Wall thickness or gauge No. 219
 TYPE OF SCREEN OR PERFORATION MATERIAL:
 1 Steel 3 Stainless steel 5 Fiberglass 7 PVC 10 Asbestos-cement
 2 Brass 4 Galvanized steel 6 Concrete tile 8 RMP (SR) 11 Other (specify)
 9 ABS 12 None used (open hole)
 SCREEN OR PERFORATION OPENINGS ARE:
 1 Continuous slot 3 Mill slot 5 Gauzed wrapped 8 Saw cut 11 None (open hole)
 2 Louvered shutter 4 Key punched 6 Wire wrapped 9 Drilled holes
 7 Torch cut 10 Other (specify)
 SCREEN-PERFORATED INTERVALS: From 186 ft. to 226 ft., From 14% Slots ft. to ft.
 From 226 ft. to 236 ft., From Cook Screen ft. to ft.
 GRAVEL PACK INTERVALS: From 10 ft. to 236 ft., From ft. to ft.
 From ft. to ft., From ft. to ft.

6 GROUT MATERIAL: 1 Neat cement 2 Cement grout 3 Bentonite 4 Other
 Grout intervals: From 0 ft. to 10 ft., From ft. to ft., From ft. to ft.
 What is the nearest source of possible contamination:
 1 Septic tank 4 Lateral lines 7 Pit privy 10 Livestock pens 14 Abandoned water well
 2 Sewer lines 5 Cess pool 8 Sewage lagoon 11 Fuel storage 15 Oil well/Gas well
 3 Watertight sewer lines 6 Seepage pit 9 Feedyard 12 Fertilizer storage 16 Other (specify below)
 13 Insecticide storage
 Direction from well? South How many feet? 3900

FROM	TO	LITHOLOGIC LOG	FROM	TO	LITHOLOGIC LOG
0	165	Clay	233	251	Ochre
165	173	Medium Sand	251	256	Shale
173	179	Clay			
179	191	Fine to Medium Sand			
191	192	Clay Layers			
192	201	Medium Sand			
201	205	Caliche & Clay			
205	206	Clay			
206	212	Medium Sand			
212	213	Caliche & Cemented Sand			
213	219	Medium Sand			
219	220	Clay			
220	222	Medium Sand			
222	223	Clay			
223	233	Medium to Coarse sand & Gravel			

7 CONTRACTOR'S OR LANDOWNER'S CERTIFICATION: This water well was (1) constructed, (2) reconstructed, or (3) plugged under my jurisdiction and was completed on (mo/day/year) 7-5-85 and this record is true to the best of my knowledge and belief. Kansas Water Well Contractor's License No. 394 This Water Well Record was completed on (mo/day/yr) 6-24-86 under the business name of Woofter Pump & Well by (signature) [Signature]

INSTRUCTIONS: Use typewriter or ball point pen. PLEASE PRESS FIRMLY and PRINT clearly. Please fill in blanks, underline or circle the correct answers. Send top three copies to Kansas Department of Health and Environment, Office of Oil Field and Environmental Geology, Regulation and Permitting Section, Topeka, Kansas 66620-7500, Telephone: 913-862-9360. Send one to WATER WELL OWNER and retain one for your records.