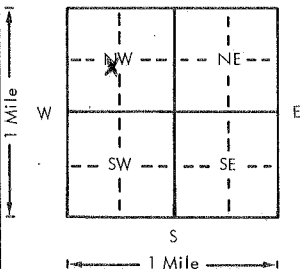


USE TYPEWRITER OR BALL POINT PEN—PRESS FIRMLY, PRINT CLEARLY.

WATER WELL RECORD
KSA 82a-1201-1215

Kansas Department of Health and Environment—Division of Environment
(Water well Contractors)
Topeka, Kansas 66620

1. Location of well:		County <i>Sheridan</i>	Fraction <i>NE 1/4 SW 1/4 NW 1/4</i>	Section number <i>6</i>	Township number T <i>7</i> S R	Range number <i>29</i> E (W)
2. Distance and direction from nearest town or city: <i>4 1/4 South</i> Street address of well location if in city: <i>Seldon, Kas. 2 3/4 West</i>				3. Owner of well: <i>Dick Stevenson</i> R.R. or street: City, state, zip code: <i>Seldon Kansas</i>		
4. Locate with "X" in section below: N  W E S 1 Mile				Sketch map:		6. Bore hole dia. <i>30</i> in. Completion date Well depth <i>166</i> ft. <i>3-20-51</i>
5. Type and color of material				From	To	7. <input checked="" type="checkbox"/> Cable tool <input checked="" type="checkbox"/> Rotary <input type="checkbox"/> Driven <input type="checkbox"/> Dug <input type="checkbox"/> Hollow rod <input type="checkbox"/> Jetted <input type="checkbox"/> Bored <input type="checkbox"/> Reverse rotary
<i>Top Soil</i>				<i>0</i>	<i>3</i>	8. Use: <input checked="" type="checkbox"/> Domestic <input type="checkbox"/> Public supply <input type="checkbox"/> Industry <input checked="" type="checkbox"/> Irrigation <input type="checkbox"/> Air conditioning <input type="checkbox"/> Stock <input type="checkbox"/> Lawn <input type="checkbox"/> Oil field water <input type="checkbox"/> Other
<i>Clay</i>				<i>3</i>	<i>90</i>	9. Casing: Material <i>Steel</i> Height Above or below Threaded <input type="checkbox"/> Welded <input checked="" type="checkbox"/> Surface <i>14</i> in. RMP <input type="checkbox"/> PVC Weight <i>32</i> lbs./ft. Dia. <i>16</i> in. to <i>166</i> ft. depth Wall Thickness: inches or Dia. <input type="checkbox"/> in. to <input type="checkbox"/> ft. depth gage No. <i>7</i>
<i>Porous Rock & Sandy Clay</i>				<i>90</i>	<i>113</i>	10. Screen: Manufacturer's name <i>Hastings Grain Bin Co.</i> Type <i>Free Flow</i> Dia. <i>16</i> Slot/gauge <i>60'</i> Length <i>60'</i> Set between <i>106</i> ft. and <i>166</i> ft. <input type="checkbox"/> ft. and <input type="checkbox"/> ft. Gravel pack? <input checked="" type="checkbox"/> Size range of material <i>4 to 5/8</i>
<i>Gravel</i>				<i>113</i>	<i>115</i>	11. Static water level: <i>118</i> ft. below land surface Date <i>3-22-51</i> mo./day/yr.
<i>Porous Rock & Sandy Clay</i>				<i>115</i>	<i>130</i>	12. Pumping level below land surfaces: <i>164</i> ft. after <i>4</i> hrs. pumping <i>750</i> g.p.m. <input type="checkbox"/> ft. after <input type="checkbox"/> hrs. pumping <input type="checkbox"/> g.p.m. Estimated maximum yield <i>750</i> g.p.m.
<i>Sand & gravel</i>				<i>130</i>	<i>163</i>	13. Water sample submitted: mo./day/yr. <input type="checkbox"/> Yes <input checked="" type="checkbox"/> No Date
<i>Shale</i>				<i>163</i>	<i>166</i>	14. Well head completion: <input type="checkbox"/> Pitless adapter <i>16"</i> Inches above grade
						15. Well grouted? <input checked="" type="checkbox"/> With: <input type="checkbox"/> Neat cement <input checked="" type="checkbox"/> Bentonite <input type="checkbox"/> Concrete Depth: From <i>0</i> ft. to <i>10</i> ft.
						16. Nearest source of possible contamination: ft. <input type="checkbox"/> Direction <i>North</i> Type <input type="checkbox"/> Well disinfected upon completion? <input type="checkbox"/> Yes <input type="checkbox"/> No
						17. Pump: <input type="checkbox"/> Not installed Manufacturer's name <i>Western Land Rollo</i> Model number <i>6M370</i> HP <i>60</i> Volts <i>480</i> Length of drop pipe <i>160</i> ft. capacity <i>600</i> g.p.m. Type: <input type="checkbox"/> Submersible <input checked="" type="checkbox"/> Turbine <input type="checkbox"/> Jet <input type="checkbox"/> Reciprocating <input type="checkbox"/> Centrifugal <input type="checkbox"/> Other
(Use a second sheet if needed)						
18. Elevation:		19. Remarks:				20. Water well contractor's certification: This well was drilled under my jurisdiction and this report is true to the best of my knowledge and belief. <i>Jack Lore</i> <i>Drilling</i> <i>197</i> Business name License No. Address <i>McDonald Kas. 67745</i> Signed <i>Jack Lore</i> Date <i>3-22-51</i> Authorized representative
Topography: <input type="checkbox"/> Hill <input type="checkbox"/> Slope <input checked="" type="checkbox"/> Upland <input type="checkbox"/> Valley						

Forward the white, blue and pink copies to the Department of Health and Environment

Form WWC-5