


1 LOCATION OF WATER WELL: County: Sheridan Fraction SE 1/4 SW 1/4 SW 1/4 Section Number 16 Township Number T 7 S Range Number R 29 E

Distance and direction from nearest town or city street address of well if located within city?  
7.5 + 1/2 Selden, KS

2 WATER WELL OWNER: Jake J. James  
RR#, St. Address, Box #: RI Selden, KS 67757  
City, State, ZIP Code: Selden, KS 67757  
Board of Agriculture, Division of Water Resources  
Application Number:

3 LOCATE WELL'S LOCATION WITH AN "X" IN SECTION BOX:

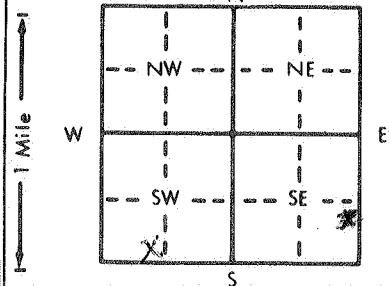










Direction from well? How many feet?

FROM	TO	LITHOLOGIC LOG	FROM	TO	PLUGGING INTERVALS
			TD	11	Sand, clay, in bottom
			11	7	Well was dry - cement grout top 3-4 ft. + 7 ft
			7	0	clay on top

RECEIVED

NOV 30 1989

DIVISION OF ENVIRONMENT

7 CONTRACTOR'S OR LANDOWNER'S CERTIFICATION: This water well was (1) constructed, (2) reconstructed, or (3) plugged under my jurisdiction and was completed on (mo/day/year) May 30, 1989 and this record is true to the best of my knowledge and belief. 