USE TYPEWRITER OR BALL POINT PEN-PRESS FIRMLY, PRINT CLEARLY.

ACC

WATER WELL RECORD
KSA 82a-1201-1215

Kansas Department of Health and Environment-Division of Environment
(Water well Contractors)
Topeka, Kansas 66620

1. Location of well:	County	Fraction	Section number	Township number	Range number
	Sheridan	SW 1/4 ~~SE~~ 1/4 NE 1/4	31	T 7 S	R 29 E/W

2. Distance and direction from nearest town or city: 8½ W - 3½ N
Street address of well location if in city: Hoxie Ks.

3. Owner of well: Harold Stephens
R.R. or street:
City, state, zip code: Grinnell Kansas

4. Locate with "X" in section below:

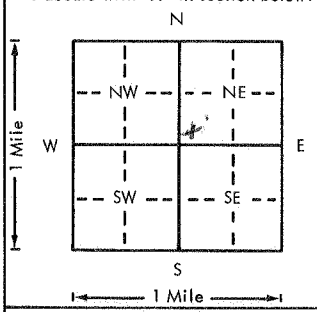

Sketch map:

6. Bore hole dia. 16 in. Completion date 5-4-76
Well depth 247 ft.

7. __ Cable tool __ Rotary __ Driven __ Dug
__ Hollow rod __ Jetted __ Bored X Reverse rotary

8. Use: __ Domestic __ Public supply __ Industry
X Irrigation __ Air conditioning __ Stock
__ Lawn __ Oil field water __ Other

9. Casing: Material Steel Height: Above or below
Threaded ___ Welded ✓ Surface 12 in.
RMP ___ PVC ___ Weight 33 lbs./ft.
Dia. 0 in. to 247 ft. depth Wall Thickness: inches or
Dia. ___ in. to ___ ft. depth gage No. .188

5. Type and color of material	From	To
Top Soil	0	135
Fine Sand Sandy Clay (Streak) Sand Stone	135	145
Fine Sand Med Gravel (Streak) Sandy Clay loose Color	145	155
" " " (Streak) loose Sand Stone Color	155	165
" " " loose Colored	165	175
" (Streak) Med Gravel Sandy Clay	175	185
Fine Sand Med Gravel (Streak) Sandy Clay (Streak) Sand Stone loose Colored	185	195
Fine Sand Med Gravel " loose Colored	195	205
" " " "	205	215
" " loose Colored	215	225
" " "	225	235
" " "	235	245
Ochre Shale	245	255
BROCK 245		
(Use a second sheet if needed)		

10. Screen: Manufacturer's name W A Brown
Type Lower Dia. 16
Slot/gauze ___ Length 60
Set between 187 ft. and 247 ft.
___ ft. and ___ ft.
Gravel pack? yes Size range of material 44 x 5/8

11. Static water level: mo./day/yr.
140 ft. below land surface Date 11-17-75

12. Pumping level below land surfaces:
245 ft. after 3 hrs. pumping 1500 g.p.m.
___ ft. after ___ hrs. pumping ___ g.p.m.
Estimated maximum yield 1500 g.p.m.

13. Water sample submitted: mo./day/yr.
___ Yes X No Date ___

14. Well head completion:
___ Pitless adapter 12 Inches above grade

15. Well grouted? yes
With: X Neat cement ___ Bentonite ___ Concrete
Depth: From 0 ft. to 10 ft.

16. Nearest source of possible contamination:
ft. ___ Direction ___ Type None
Well disinfected upon completion? ___ Yes X No

17. Pump: ___ Not installed
Manufacturer's name Hydro
Model number H400 HP 200 Volts ___
Length of drop pipe 240 ft. capacity 1500 g.p.m.
Type:
___ Submersible X Turbine
___ Jet ___ Reciprocating
___ Centrifugal ___ Other

18. Elevation:

Topography:
___ Hill
___ Slope
X Upland
___ Valley

19. Remarks:

20. Water well contractor's certification:
This well was drilled under my jurisdiction and this report is true to the best of my knowledge and belief.
Blue Jay Drilling Inc. 214
Business name License No.
Address Colby Kans
Signed Marilyn Rall Date 5-20-76
Authorized representative

T 7 R 29 E/W Sec 31 1/4 SW 1/4 SW 1/4 NE

Forward the white, blue and pink copies to the Department of Health and Environment

Form WWC-5

MI-1023