USE TYPEWRITER OR BALL POINT PEN-PRESS FIRMLY, PRINT CLEARLY.

MENCC NE

WATER WELL RECORD
KSA 82a-1201-1215

BAC

Kansas Department of Health and Environment-Division of Environment
(Water well Contractors)
Topeka, Kansas 66620

1. Location of well:	County	Fraction	Section number	Township number	Range number
	Sheridan	~~Center~~ SW 1/4 NE 1/4 NW 1/4	#34	T 7 S	R #29 ~~E~~/W

2. Distance and direction from nearest town or city: From Hoxie, Ks., 6 miles West, 3 3/4 miles North & ¼ mile East.
Street address of well location if in city:

3. Owner of well: Dr. Ruth Boxberger
R.R. or street: P.O. Box 2684
City, state, zip code: Greenville, North Carolina

4. Locate with "X" in section below:

Sketch map:

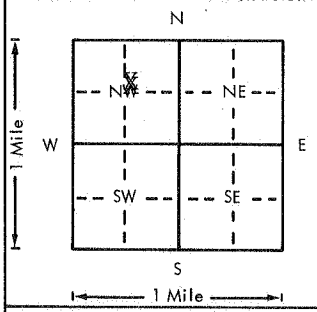

6. Bore hole dia. 28 in. Completion date 10-6-75
Well depth 274 ft.

7. __ Cable tool __ Rotary __ Driven __ Dug
__ Hollow rod __ Jetted __ Bored X Reverse rotary

8. Use: __ Domestic __ Public supply __ Industry
X Irrigation __ Air conditioning __ Stock
__ Lawn __ Oil field water __ Other

9. Casing: Material steel Height: Above or below
Threaded ___ Welded X Surface 12 in.
RMP ___ PVC ___ Weight .188 lbs./ft.
Dia. 16 in. to 184 ft. depth Wall Thickness: inches or
Dia. ___ in. to ___ ft. depth gage No. #7

10. Screen: Manufacturer's name W. A. Brown
Type perforated Dia. 16"
Slot/gauze 10% Length 80'
Set between 184 ft. and 264' ft.
10' of cook ft. and 274' ft.
Gravel pack? yes Size range of material ¼ x 5/8

11. Static water level: mo./day/yr.
160' ft. below land surface Date 10-7-75

12. Pumping level below land surfaces:
195 ft. after 2 hrs. pumping 200 g.p.m.
___ ft. after ___ hrs. pumping ___ g.p.m.
Estimated maximum yield 1200 g.p.m.

13. Water sample submitted: mo./day/yr.
___ Yes X No Date

14. Well head completion:
___ Pitless adapter 12 Inches above grade

15. Well grouted? yes
With: ___ Neat cement X Bentonite ___ Concrete
Depth: From 0 ft. to 10 ft.

16. Nearest source of possible contamination:
ft. 3000' Direction South Type Farm
Well disinfected upon completion? ___ Yes X No

17. Pump: X Not installed
Manufacturer's name
Model number ___ HP ___ Volts ___
Length of drop pipe ___ ft. capacity ___ g.p.m.
Type:
___ Submersible ___ Turbine
___ Jet ___ Reciprocating
___ Centrifugal ___ Other

5. Type and color of material	From	To
Clay & sand streaks	0	140
Clay	140	149
Medium to coarse sand & clay streaks	149	156
Clay & medium to coarse sand streaks	156	164
Medium to coarse sand	164	176
Clay	176	179
Clay & sand stone & medium to coarse sand stk.	179	196
Medium to coarse sand & clay streaks	196	207
Clay	207	210
Medium to coarse sand	210	216
Clay	216	218
Medium to coarse sand	218	223
Medium to coarse sand & clay streaks	223	233
Clay & fine to medium sand streaks	233	239
Medium to coarse sand	239	244
Sand stone	244	245
Medium to coarse sand & gravel	245	253
Clay	253	254
Coarse sand & gravel	254	273
Shale	273	274
BROCK 273		
(Use a second sheet if needed)		

18. Elevation:
Topography:
___ Hill
___ Slope
X Upland
___ Valley

19. Remarks:
2874 (TOPO)

20. Water well contractor's certification:
This well was drilled under my jurisdiction and this report is true to the best of my knowledge and belief.
Western Well & Pump, Inc. 245
Business name License No.
Address P.O. Box 852, Colby, Ks.
Signed Roy Senco Date Dec 17 75
Authorized representative

T 7 R 29 E/W Sec 34 1/4 1/4 1/4 1/4 CNW

Forward the white, blue and pink copies to the Department of Health and Environment

Form WWC-5

M1-1023