USE TYPEWRITER OR BALL POINT PEN-PRESS FIRMLY, PRINT CLEARLY.

WATER WELL RECORD
KSA 82a-1201-1215

Kansas Department of Health and Environment-Division of Enviranment
(Water well Contractors)
Topeka, Kansas 66620

1. Location of well: County: Cloud | Fraction: (1/4) 1/4 SW 1/4 | Section number: 34 | Township number: T 7 S | Range number: R 3 E/W

2. Distance and direction from nearest town or city: 10 mile so of Concordia - 1 mile east
Street address of well location if in city: 1/2 South - West side of road.

3. Owner of well: Lawerence O'Riely
R.R. or street address: Aurora, KANSAS 67417
City, state, zip code: R ft. 2

4. Locate with "X" in section below:

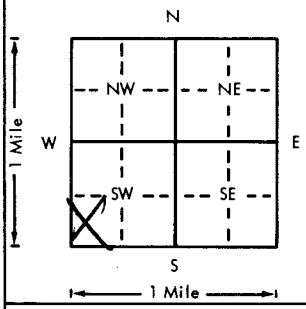

Sketch map: Pasture Well No buildings Near -

6. Bore hole dia. 8 in. Completion date April 26 1976
Well depth 153 ft.

7. __ Cable tool ✓ Rotary __ Driven __ Dug
__ Hollow rod __ Jetted __ Bored __ Reverse rotary

8. Use: ✓ Domestic __ Public supply __ Industry
__ Irrigation __ Air conditioning ✓ Stock
__ Lawn __ Oil field water __ Other

9. Casing: Material _____ Height: Above or below
Threaded ____ Welded ____ Surface 12 in.
RMP ____ PVC ✓ Weight _____ lbs./ft.
Dia. 5 in. to 153 ft. depth Wall Thickness: inches or
Dia. ____ in. to ____ ft. depth gage No. 1/4

10. Screen: Manufacturer's name: Western Plastic
Type T200 Dia. 5"
Slot/gauze 160 Length 80
Set between 132 ft. and 152 ft.
____ ft. and ____ ft.
Gravel pack? ✓ Size range of material 1/4

11. Static water level: 60 ft. below land surface Date Apr 1 30 1976

12. Pumping level below land surfaces: 140 ft. after 2 hrs. pumping 4 g.p.m.
____ ft. after ____ hrs. pumping ____ g.p.m.
Estimated maximum yield 8 g.p.m.

13. Water sample submitted: ✓ Yes ____ No Date May 2, 1976 mo./day/yr.

14. Well head completion: N/A Pitless adapter ____ Inches above grade

15. Well grouted? yes
With: ____ Neat cement ____ Bentonite ✓ Concrete
Depth: From 1 ft. to 10 ft.

16. Nearest source of possible contamination: ft. 15 Direction east Type Creek
Well disinfected upon completion? ____ Yes ____ No

17. Pump: ____ Not installed
Manufacturer's name Pump Jack installed
Model number ____ HP ____ Volts ____
Length of pump pipe 126 ft. capacity 8 g.p.m.
Type: ____ Submersible ____ Turbine
____ Jet ✓ Reciprocating
____ Centrifugal ____ Other

From	To
0	18
18	35
35	135
135	152
Clay	153

5. Type and color of material: Black dirt; Grey clay; Red clay; Sand rock; Clay

(Use a second sheet if needed)

18. Elevation: 1200
Topography: ✓ Hill ✓ Slope ____ Upland ____ Valley

19. Remarks:

20. Water well contractor's certification:
This well was drilled under my jurisdiction and this report is true to the best of my knowledge and belief. 247
Carl Thomas Son
Business name License No.
Address 333 E 16 Concordia Kansas
Signed Elmer Thomas Authorized representative Date 9/7/76

Forward the white, blue and pink copies to the Department of Health and Environment

Form WWC-5

M1-1023

T 7 R 3 E Sec 34 1/4 1/4 1/4