

USE TYPEWRITER OR BALL POINT PEN-PRESS FIRMLY, PRINT CLEARLY.

MENLO 13W

T R EW sec 1/4 1/4 1/4 No.

WATER WELL RECORD
KSA 82a-1201-1215


Kansas State Dept. Of Health
(Water Well Contractors)
Forbes-Bldg. 740
Topeka, Kansas 66620

CDB

1 Location of well:	County Sheridan	Township name Bloomfield	Fraction SE 1/4 SW 1/4	Section number 2	Town number 7	Range number 30
---------------------	---------------------------	------------------------------------	--	----------------------------	-------------------------	---------------------------

Distance and direction from nearest town or city: **5 1/4 east 1/4 north**
Rexford, Kansas
 Street address of well location if in city:

Owner of well: **James Beckman**
 Address: **Selden, Kansas**

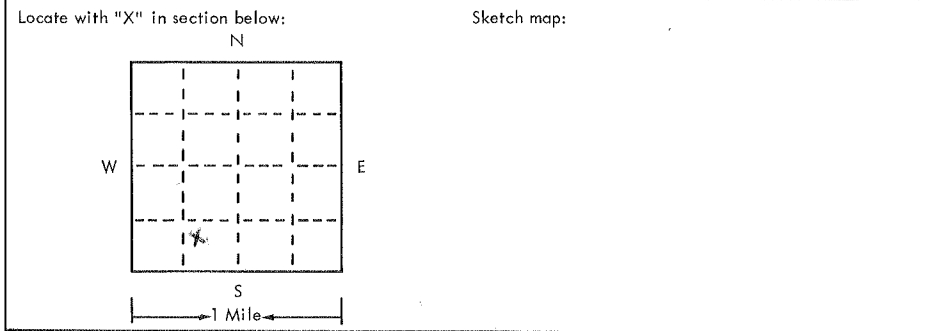

4 Well depth: **212** ft. Date of completion **3-11-75**
 Well diameter **20** in.

5 Cable tool Rotary Driven Dug
 Hollow rod Jetted Bored Reverse rotary

6 Use: Domestic Public supply Industry
 Irrigation Air conditioning Commercial
 Test well

7 Casing: Material **steel** Height: above/below
 Threaded Welded Surface **12** in.
 Diam. **12 3/4** Weight **33** lbs./ft. **1**
0 in. to **212** ft. depth Drive shoe? Yes No
 ___ in. to ___ ft. depth

2	Type and color of material	From	To
	Top soil	0	95
	Clay, Med. gravel red	95	98
	Sandy clay, rock, sandstone	98	115
	Clay, med. gravel red	115	118
	Clay, sandstone	118	150
	Clay, med. gravel, sandy clay red	150	154
	Sandy clay, rock, sandstone	154	166
	Clay med gravel red	166	168
	Sandy clay, rock, sandstone	168	171
	Clay, med. gravel red	171	176
	Med. gravel, sandy clay, sandstone	176	179
	Med. gravel red	179	209
	Ochre - shale	209	215
	BROCK 209'		
	(use a second sheet if needed)		

8 Screen: Manufacturer **W. A. Brown**
 Type **Luver** Dia. **12 3/4**
 Slot/gauze **7 - 1/8** Length **60**
 Set between **152** ft. and **212** ft.

Fittings:
 Gravel pack Yes No Size range of material **1/4** x **5/8**

9 Static water level:
94 ft. below land surface Date **1-21-75**

10 Pumping level below land surfaces:
209 ft. after **10** hrs. pumping **1250** g.p.m.
 ___ ft. after ___ hrs. pumping ___ g.p.m.
 Estimated maximum yield **1250** g.p.m.

11 Water sample submitted:
 Yes No Date ___

12 Well head completion:
 Pitless adapter **12** Inches above grade

13 Well grouted? Yes No
 Neat cement Bentonite ___
 Depth: From **0** ft. to **10** ft.

14 Nearest source of possible contamination:
 ft. ___ Direction ___ Type **None**
 Well disinfected upon completion? Yes No

15 Pump: Not installed
 Manufacturer's name **Hydro**
 Model number **L300** HP **100** Volts ___
 Length of drop pipe **200** ft. capacity ___ g.m.p.
 Type:
 Submersible Turbine
 Jet Reciprocating
 Centrifugal Other

16 Remarks: elevation **2883 (TOPO)**

Topography:
 Hill
 Slope
 Upland
 Valley

17 Water well contractor's certification:
 This well was drilled under my jurisdiction and this report is true to the best of my knowledge and belief.
Blue Jay Drilling Co. Inc. 214
 Business name License No.
 Address **Colby, Kansas**
 Signed **Maulyn Hall** Date **3-15-75**
 Authorized representative