

USE TYPEWRITER OR BALL POINT PEN—PRESS FIRMLY, PRINT CLEARLY.

Menlo NW

T R EW sec 1/4 1/4 1/4 No.


WATER WELL RECORD
KSA 82a-1201-1215

Kansas State Dept. Of Health
(Water Well Contractors)
Forbes-Bldg, 740
Topeka, Kansas 66620

BDD

1 Location of well:	County Sheridan	Township name Bloomfield	Fraction SE-SE 1/4 of NW 1/4	Section number 21	Town number 7	Range number 30
---------------------	---------------------------	------------------------------------	--	-----------------------------	-------------------------	---------------------------

Distance and direction from nearest town or city: Street address of well location if in city: 3 Miles & 2 1/2 Miles East of Menlo, KS.	3 Owner of well: Address: Mark Hueftle Selden, KS.
--	--

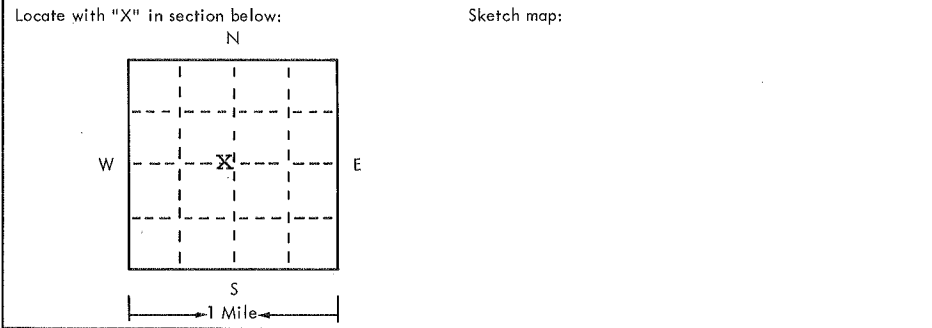

4 Well depth: 277 ft. Date of completion 4-29-75
Well diameter 28 in.

5 Cable tool Rotary Driven Dug
 Hollow rod Jetted Bored Reverse rotary

6 Use: Domestic Public supply Industry
 Irrigation Air conditioning Commercial
 Test well

7 Casing: Material Steel Weight: above/below
Threaded Welded Surface 12 in.
Diam. 7 Weight guage /ft.
0 in. to 187 ft. depth Drive shoe? Yes No
 in. to ft. depth

2 Type and color of material	From	To
Clay and sand streaks	0	147
Fine to coarse sand and gravel	147	150
Sandy clay and cemented streaks	150	160
Fine to coarse sand & cemented streaks	160	163
Sandy clay and cemented streaks	163	171
Fine to coarse sand and gravel	171	183
Cemented sand	183	187
Fine to coarse sand and gravel	187	201
Sandy clay & cemented sandy clay	201	220
Fine to coarse sand and gravel	220	232
Sandy clay	232	260
Fine to coarse sand	260	266
Sandy clay	266	269
Ochre clay	269	274
Shale	274	277
(use a second sheet if needed)		

8 Screen:
Manufacturer W.A. Brown
Type Bridge Dia. 16"
Slot/gauze 1/8 Length 2"
Set between 187 ft. and 267 ft.
Fittings: 10' Cook - 267 to 277
Gravel pack Yes No Size range of material 1/4 x 5/8

9 Static water level:
140 ft. below land surface Date 5-1-75

10 Pumping level below land surfaces:
260 ft. after 2 hrs. pumping 1100 g.p.m.
 ft. after hrs. pumping g.p.m.
Estimated maximum yield 1100 g.p.m.

11 Water sample submitted:
 Yes No Date

12 Well head completion:
 Pitless adapter 12" inches above grade

13 Well grouted? Yes No
 Neat cement Bentonite Clay
Depth: From 0 ft. to 10 ft.

14 Nearest source of possible contamination:
ft. 1 mi. Direction South Type HOME
Well disinfected upon completion? Yes No

15 Pump: Not installed
Manufacturer's name Hydru
Model number 8 HP 100 Volts
Length of drop pipe 265 ft. capacity 1100 g.p.m.
Type:
 Submersible Turbine
 Jet Reciprocating
 Centrifugal Other

16 Remarks: elevation 2962 (TOPO)

Topography:
 Hill
 Slope
 Upland
 Valley

17 Water well contractor's certification:
This well was drilled under my jurisdiction and this report is true to the best of my knowledge and belief.
Western Well & Pump, Inc. 245
Business name License No.
Address Box 852, Colby, KS.
Signed Roy F. Senior Date 6-14-75
Authorized representative