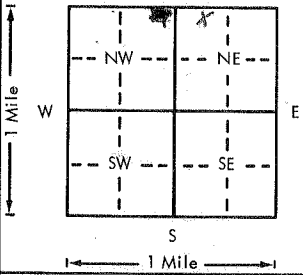


USE TYPEWRITER OR BALL POINT PEN-PRESS FIRMLY, PRINT CLEARLY.

ABB

WATER WELL RECORD
KSA 82a-1201-1215

Kansas Department of Health and Environment-Division of Environment
(Water well Contractors)
Topeka, Kansas 66620

1. Location of well: County <u>Sheridan</u> Fraction <u>NW 1/4 NW 1/4 NE 1/4</u> Section number <u>32</u> Township number <u>T 7 S R 30 E/W</u> Range number	
2. Distance and direction from nearest town or city: <u>4 N, 1 3/4 E</u> Street address of well location if in city: <u>OF MENLO KANSAS</u>	
3. Owner of well: <u>Rumen Boggs</u> R.R. or street: City, state, zip code: <u>Selden Kansas</u>	
4. Locate with "X" in section below: Sketch map: 	
5. Type and color of material	
6. Bore hole dia. <u>28</u> in. Completion date <u>3-31-76</u> Well depth <u>380</u> ft.	
7. <input type="checkbox"/> Cable tool <input type="checkbox"/> Rotary <input type="checkbox"/> Driven <input type="checkbox"/> Dug <input type="checkbox"/> Hollow rod <input type="checkbox"/> Jetted <input type="checkbox"/> Bored <input checked="" type="checkbox"/> Reverse rotary	
8. Use: <input type="checkbox"/> Domestic <input type="checkbox"/> Public supply <input type="checkbox"/> Industry <input checked="" type="checkbox"/> Irrigation <input type="checkbox"/> Air conditioning <input type="checkbox"/> Stock <input type="checkbox"/> Lawn <input type="checkbox"/> Oil field water <input type="checkbox"/> Other	
9. Casing: Material: <u>Steel</u> Height: <u>Above</u> or below Threading: <input type="checkbox"/> Threaded <input checked="" type="checkbox"/> Welded Surface: <u>12</u> in. RMP: <input type="checkbox"/> PVC Weight: <u>3.3</u> lbs./ft. Dia. <u>2</u> in. to <u>28</u> ft. depth Wall Thickness: inches or Dia. <input type="checkbox"/> in. to <input type="checkbox"/> ft. depth gage No. <u>188</u>	
10. Screen: Manufacturer's name <u>W A Brown</u> Type <u>Screen</u> Dia. <u>16</u> Slot/gauze <u>28</u> Length <u>60</u> Set between <u>220</u> ft. and <u>280</u> ft. Gravel pack? <input checked="" type="checkbox"/> Size range of material <u>1/4 X 3/8</u>	
11. Static water level: <u>155</u> ft. below land surface Date <u>4-9-76</u> mo./day/yr.	
12. Pumping level below land surfaces: <u>277</u> ft. after <u>3</u> hrs. pumping <u>700</u> g.p.m. Estimated maximum yield <u>700</u> g.p.m.	
13. Water sample submitted: <input checked="" type="checkbox"/> Yes <input type="checkbox"/> No Date	
14. Well head completion: <input type="checkbox"/> Pitless adapter <u>12</u> inches above grade	
15. Well grouted? <input checked="" type="checkbox"/> Yes <input type="checkbox"/> No With: <input checked="" type="checkbox"/> Neat cement <input type="checkbox"/> Bentonite <input type="checkbox"/> Concrete Depth: From <u>0</u> ft. to <u>10</u> ft.	
16. Nearest source of possible contamination: ft. Direction Type <u>None</u> Well disinfected upon completion? <input type="checkbox"/> Yes <input checked="" type="checkbox"/> No	
17. Pump: <input type="checkbox"/> Not installed Manufacturer's name <u>Bould</u> Model number <u>10120</u> HP <u>200</u> Volts Length of drop pipe <u>270</u> ft. capacity <u>700</u> g.p.m. Type: <input type="checkbox"/> Submersible <input checked="" type="checkbox"/> Turbine <input type="checkbox"/> Jet <input type="checkbox"/> Reciprocating <input type="checkbox"/> Centrifugal <input type="checkbox"/> Other	
18. Elevation: Topography: <input type="checkbox"/> Hill <input type="checkbox"/> Slope <input checked="" type="checkbox"/> Upland <input type="checkbox"/> Valley	
19. Remarks: <u>(Use a second sheet if needed) BROCK</u>	
20. Water well contractor's certification: This well was drilled under my jurisdiction and this report is true to the best of my knowledge and belief. Business name: <u>Blumley Drilling Co. 214</u> License No. Address: <u>Calley St</u> Signed: <u>Maurya Rell</u> Date: <u>4-8-76</u> Authorized representative	

7 300 32 NW 1/4 NE 1/4

Forward the white, blue and pink copies to the Department of Health and Environment

Form WWC-5