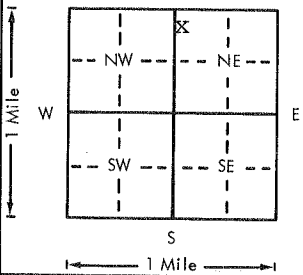


USE TYPEWRITER OR BALL POINT PEN-PRESS FIRMLY, PRINT CLEARLY.

WATER WELL RECORD
KSA 82a-1201-1215

AB13

Kansas Department of Health and Environment-Division of Environment
(Water well Contractors)
Topeka, Kansas 66620

1. Location of well:	County Sheridan	Fraction NW 1/4 NW 1/4 NE 1/4	Section number 34	Township number T 7 S	Range number R 30	W
2. Distance and direction from nearest town or city: #24-Menlo Rd.; 3 3/4 East; 2 North Street address of well location if in city:			3. Owner of well: John Moss R.R. or street: City, state, zip code: Menlo, Kansas			
4. Locate with "X" in section below: N  W E S 1 Mile			Sketch map:			6. Bore hole dia. 30 in. Completion date 10-12-76 Well depth 262 ft.
5. Type and color of material			From	To	7. <input type="checkbox"/> Cable tool <input type="checkbox"/> Rotary <input type="checkbox"/> Driven <input type="checkbox"/> Dug <input type="checkbox"/> Hollow rod <input type="checkbox"/> Jetted <input type="checkbox"/> Bored <input checked="" type="checkbox"/> Reverse rotary	
Clay			0	72	8. Use: <input type="checkbox"/> Domestic <input type="checkbox"/> Public supply <input type="checkbox"/> Industry <input checked="" type="checkbox"/> Irrigation <input type="checkbox"/> Air conditioning <input type="checkbox"/> Stock <input type="checkbox"/> Lawn <input type="checkbox"/> Oil field water. <input type="checkbox"/> Other	
Med. Gravel, STreaks of Clay			72	100	9. Casing: Material Steel Height: Above or Below XXXX Threaded <input type="checkbox"/> Welded <input checked="" type="checkbox"/> Surface 16" in. RMP <input type="checkbox"/> PVC <input type="checkbox"/> Weight 188 lbs./ft. Dia. 16 in. to 182 ft. depth Wall Thickness: inches or Dia. <input type="checkbox"/> in. to <input type="checkbox"/> ft. depth gage No. #7	
Sandy Clay, Sand STone Streaks			100	134	10. Screen: Manufacturer's name K& Brown Type Regular Dia. 16" Slot/gauze 10% Length 80' Set between 182 ft. and 262 ft. <input type="checkbox"/> ft. and <input type="checkbox"/> ft. Gravel pack? <input checked="" type="checkbox"/> Size range of material 2x5/8 30 #170%	
Coarse Sand			134	140	11. Static water level: <input type="checkbox"/> mo./day/yr. 137 ft. below land surface Date 10-12-76	
Fine Sand, Clay, Sand Stone Streaks			140	166	12. Pumping level below land surfaces: 256 ft. after 2 hrs. pumping 1284 g.p.m. <input type="checkbox"/> ft. after <input type="checkbox"/> hrs. pumping <input type="checkbox"/> g.p.m. Estimated maximum yield 1284 g.p.m.	
Med. Gravel, Clay Streaks			166	180	13. Water sample submitted: <input type="checkbox"/> mo./day/yr. <input type="checkbox"/> Yes <input checked="" type="checkbox"/> No Date <input type="checkbox"/>	
Sandy Clay, Sand Stone Streaks			180	225	14. Well head completion: <input type="checkbox"/> Pitless adapter <input type="checkbox"/> 12 Inches above grade	
Med. Gravel, Sand Stone Streaks, Clay			225	240	15. Well grouted? <input checked="" type="checkbox"/> With: <input type="checkbox"/> Neat cement <input checked="" type="checkbox"/> Bentonite <input checked="" type="checkbox"/> Clay <input checked="" type="checkbox"/> Depth: From 30 30 ft. to 10 ft.	
Coarse Sand, Med. Gravel			240	256	16. Nearest source of possible contamination: ft. 5000' Direction SW Type House Well disinfected upon completion? <input type="checkbox"/> Yes <input checked="" type="checkbox"/> No	
Ochre, Shale			256	262	17. Pump: <input type="checkbox"/> Not installed Manufacturer's name Hydro Model number <input type="checkbox"/> HP <input type="checkbox"/> Volts <input type="checkbox"/> Length of drop pipe 250 ft. capacity 600 g.p.m. Type: <input checked="" type="checkbox"/> 5 Stage 12" M <input type="checkbox"/> Submersible <input checked="" type="checkbox"/> Turbine <input type="checkbox"/> Jet <input type="checkbox"/> Reciprocating <input type="checkbox"/> Centrifugal <input type="checkbox"/> Other	
(Use a second sheet if needed)					20. Water well contractor's certification: This well was drilled under my jurisdiction and this report is true to the best of my knowledge and belief. Western Well & Pump 245 Business name License No. Address Box 852, Colby, KS Signed Sally Berry Date 11/15/74 Authorized representative	
18. Elevation:	19. Remarks:		20. Water well contractor's certification:			
Topography: <input type="checkbox"/> Hill <input type="checkbox"/> Slope <input checked="" type="checkbox"/> Upland <input type="checkbox"/> Valley						

1-7 30W 34 Sec 1/4 1/4 NE

Forward the white, blue and pink copies to the Department of Health and Environment

Form WWC-5