USE TYPEWRITER OR BALL POINT PEN-PRESS FIRMLY, PRINT CLEARLY.

WATER WELL RECORD
KSA 82a-1201-1215

Kansas Department of Health and Environment-Division of Environment
(Water well Contractors)
Topeka, Kansas 66620

1. Location of well:	County	Fraction	Section number	Township number	Range number
	Sheridan	NW 1/4 SE 1/4 NE 1/4	35	T 7 S	R 30 E/W

2. Distance and direction from nearest town or city: 10 W 2 N ½W ¼S
Street address of well location if in city: from HOXIE

3. Owner of well: Leo Wessel
R.R. or street:
City, state, zip code: Menlo, Ks. 67746

4. Locate with "X" in section below:

Sketch map:

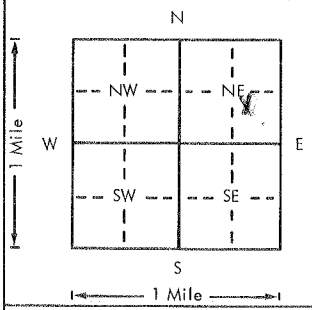

6. Bore hole dia. 9 in. Completion date 4-13-81
Well depth 240 ft.

7. ___ Cable tool X Rotary ___ Driven ___ Dug
___ Hollow rod ___ Jetted ___ Bored ___ Reverse rotary

8. Use: X Domestic ___ Public supply ___ Industry
___ Irrigation ___ Air conditioning ___ Stock
___ Lawn ___ Oil field water ___ Other

9. Casing: Material Styrene Height: Above or below
Threaded ___ Welded ___ Surface 12 in.
RMP ___ PVC ___ Weight 1.75 lbs./ft.
Dia. 5 in. to 240 ft. depth Wall Thickness: inches or
Dia. ___ in. to ___ ft. depth gage No. .214

5. Type and color of material

	From	To
Sand & Clay Layers	0	137
Medium Sand	137	146
Caliche	146	148
Clay	148	154
Fine to Med. Sand	154	156
Clay	156	162
Med. Sand	162	168
Caliche	168	173
Med. Sand	173	176
Clay	176	180
Caliche	180	193
Clay & Fine Sand	193	203
Caliche	203	210
Fine to Med. Sand	210	226
Med. to Coarse Sand	226	239
Oschre	239	255

(Use a second sheet if needed)

10. Screen: Manufacturer's name
Type Styrene Slot Dia. 5 in.
Slot/gauze ___ Length
Set between 220 ft. and 240 ft.
___ ft. and ___ ft.
Gravel pack? X Size range of material ¼ in.

11. Static water level: 146 ft. below land surface Date 4-13-81 mo./day/yr.

12. Pumping level below land surfaces:
___ ft. after ___ hrs. pumping ___ g.p.m.
___ ft. after ___ hrs. pumping ___ g.p.m.
Estimated maximum yield ___ g.p.m.

13. Water sample submitted: mo./day/yr.
___ Yes X No Date

14. Well head completion:
X Pitless adapter ___ Inches above grade

15. Well grouted? yes
With: X Neat cement ___ Bentonite ___ Concrete
Depth: From 5 ft. to 15 ft.

16. Nearest source of possible contamination:
ft. 500 Direction N Type Cesspool
Well disinfected upon completion? X ___ Yes ___ No

17. Pump: X Not installed
Manufacturer's name
Model number ___ HP ___ Volts ___
Length of drop pipe ___ ft. capacity ___ g.p.m.
Type:
___ Submersible ___ Turbine
___ Jet ___ Reciprocating
___ Centrifugal ___ Other

18. Elevation:

Topography:
___ Hill
___ Slope
___ Upland
___ Valley

19. Remarks:

20. Water well contractor's certification:
This well was drilled under my jurisdiction and this report is true to the best of my knowledge and belief.
Business name F & W Drilling License No. 394A
Address Rt. 1 Hoxie, Ks. 67740
Signed Walt Wraft Date
Authorized representative

T 7 S R 30 (W) Sec 35 1/4 1/4 1/4

Forward the white, blue and pink copies to the Department of Health and Environment

Form WWC-5

MI-1023