WATER WELL RECORD Form WWC-5 KSA 82a-1212 PLUGGING REPORT

**1 LOCATION OF WATER WELL:**
County: SHERIDAN | Fraction: SE ¼ SE ¼ NE ¼ | Section Number: 36 | Township Number: T 7 S | Range Number: R 30 E/W

Distance and direction from nearest town or city street address of well if located within city?
8½ west & 2½ north of Hoxie KS

**2 WATER WELL OWNER:** NW Kansas Groundwater Management District #4
RR#, St. Address, Box # : P.O. Box 905 1175 S. Range
City, State, ZIP Code : Colby, KS 67701-0905
Board of Agriculture, Division of Water Resour
Application Number: NONE

**3 LOCATE WELL'S LOCATION WITH AN "X" IN SECTION BOX:**

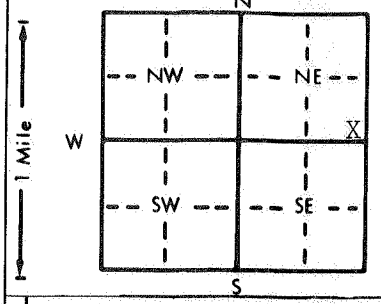


**4 DEPTH OF COMPLETED WELL** 120 ft. ELEVATION:
Depth(s) Groundwater Encountered 1. 117 ft. 2. ft. 3. f
WELL'S STATIC WATER LEVEL ft. below land surface measured on mo/day/yr
Pump test data: Well water was ft. after hours pumping gp
Est. Yield gpm: Well water was ft. after hours pumping gp
Bore Hole Diameter in. to ft., and in. to
WELL WATER TO BE USED AS: 5 Public water supply 8 Air conditioning 11 Injection well
1 Domestic 3 Feedlot 6 Oil field water supply 9 Dewatering 12 Other (Specify below)
2 Irrigation 4 Industrial 7 Lawn and garden only X 10 Observation well
Was a chemical/bacteriological sample submitted to Department? Yes No X ; If yes, mo/day/yr sample was s mitted
Water Well Disinfected? Yes No

**5 TYPE OF BLANK CASING USED:** 5 Wrought iron 8 Concrete tile CASING JOINTS: Glued Clamped
1 Steel 3 RMP (SR) 6 Asbestos-Cement 9 Other (specify below) Welded
X 2 PVC 4 ABS 7 Fiberglass Threaded
Blank casing diameter 2 inch in. to 120 ft., Dia in. to ft., Dia in. to
Casing height above land surface 8 in., weight lbs./ft. Wall thickness or gauge No.

TYPE OF SCREEN OR PERFORATION MATERIAL: X 7 PVC 10 Asbestos-cement
1 Steel 3 Stainless steel 5 Fiberglass 8 RMP (SR) 11 Other (specify)
2 Brass 4 Galvanized steel 6 Concrete tile 9 ABS 12 None used (open hole)

SCREEN OR PERFORATION OPENINGS ARE: 5 Gauzed wrapped 8 Saw cut 11 None (open hole)
1 Continuous slot 3 Mill slot 6 Wire wrapped 9 Drilled holes
2 Louvered shutter 4 Key punched 7 Torch cut 10 Other (specify)

SCREEN-PERFORATED INTERVALS: From ft. to ft., From ft. to
From ft. to ft., From ft. to
GRAVEL PACK INTERVALS: From ft. to ft., From ft. to
From ft. to ft., From ft. to

**6 GROUT MATERIAL:** 1 Neat cement 2 Cement grout 3 Bentonite 4 Other
Grout Intervals: From ft. to ft., From ft. to ft., From ft. to

What is the nearest source of possible contamination:
1 Septic tank 4 Lateral lines 7 Pit privy 10 Livestock pens 14 Abandoned water well
2 Sewer lines 5 Cess pool 8 Sewage lagoon 11 Fuel storage 15 Oil well/Gas well
3 Watertight sewer lines 6 Seepage pit 9 Feedyard 12 Fertilizer storage 16 Other (specify below)
13 Insecticide storage
Direction from well? How many feet?

| FROM | TO | LITHOLOGIC LOG | FROM | TO | LITHOLOGIC LOG |
|---|---|---|---|---|---|
| 120 | 3 | plugged well with neat portland | | | |
| | | cement, with PVC cap on top | | | |
| 3 | 0 | surface silt and clay | | | |

**7 CONTRACTOR'S OR LANDOWNER'S CERTIFICATION:** This water well was (1) constructed, (2) reconstructed, or (3) plugged under my jurisdiction and wa completed on (mo/day/year) October 30, 1986 and this record is true to the best of my knowledge and belief. Kansa
Water Well Contractor's License No. This Water Well Record was completed on (mo/day/yr) October 30, 1986
under the business name of by (signature) Keith Reaves

INSTRUCTIONS: Use typewriter or ball point pen. *PLEASE PRESS FIRMLY* and *PRINT* clearly. Please fill in blanks, underline or circle the correct answers. Send top three copies to Kansas Department of Health and Environment, Office of Oil Field and Environmental Geology, Regulation and Permitting Section, Topeka, Kansas 66620-7500, Telephone: 913-862-9360. Send one to WATER WELL OWNER and retain one for your records.