


1 LOCATION OF WATER WELL: Fraction SW 1/4 SW 1/4 SW 1/4 Section Number 20 Township Number T 7 S Range Number R 30 E 1  
 County Sheridan

Distance and direction from nearest town or city street address of well if located within city?  
14 Miles West 3 1/2 Miles North of Hoxie

2 WATER WELL OWNER: Jay Flanagin  
 RR#, St. Address, Box #: HC1 Box 53A Board of Agriculture, Division of Water Resource  
 City, State, ZIP Code: Selden, Ks. 67757 Application Number:

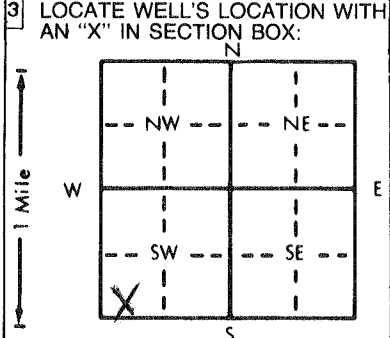

4 DEPTH OF COMPLETED WELL: 237 ft. ELEVATION: .....  
 Depth(s) Groundwater Encountered 1. .... ft. 2. .... ft. 3. .... ft.  
 WELL'S STATIC WATER LEVEL: 140 ft. below land surface measured on mo/day/yr  
 Pump test data: Well water was ..... ft. after ..... hours pumping ..... gpm  
 Est. Yield ..... gpm: Well water was ..... ft. after ..... hours pumping ..... gpm  
 Bore Hole Diameter: 8 in. to 237 ft., and ..... in. to ..... ft.  
 WELL WATER TO BE USED AS:  
 1 Domestic 3 Feedlot 6 Oil field water supply 9 Dewatering 12 Other (Specify below)  
 2 Irrigation 4 Industrial 7 Lawn and garden only 10 Monitoring well  
 Was a chemical/bacteriological sample submitted to Department? Yes.....No. X.....; If yes, mo/day/yr sample was submitted  
 Water Well Disinfected? Yes X No

5 TYPE OF BLANK CASING USED:  
 1 Steel 3 RMP (SR) 5 Wrought iron 8 Concrete tile CASING JOINTS: Glued X Clamped .....  
 2 PVC 4 ABS 6 Asbestos-Cement 9 Other (specify below) Welded .....  
 7 Fiberglass Threaded .....  
 Blank casing diameter: 4.5 in. to 197 ft., Dia ..... in. to ..... ft., Dia ..... in. to ..... ft.  
 Casing height above land surface: 18 in., weight 2.38 lbs./ft. Wall thickness or gauge No. 248  
 TYPE OF SCREEN OR PERFORATION MATERIAL:  
 1 Steel 3 Stainless steel 5 Fiberglass 7 PVC 10 Asbestos-cement  
 2 Brass 4 Galvanized steel 6 Concrete tile 8 RMP (SR) 11 Other (specify) .....  
 9 ABS 12 None used (open hole)  
 SCREEN OR PERFORATION OPENINGS ARE:  
 1 Continuous slot 3 Mill slot 5 Gauzed wrapped 8 Saw cut 11 None (open hole)  
 2 Louvered shutter 4 Key punched 6 Wire wrapped 9 Drilled holes  
 7 Torch cut 10 Other (specify) .....  
 SCREEN-PERFORATED INTERVALS: From 197 ft. to 237 ft., From ..... ft. to ..... ft.  
 From ..... ft. to ..... ft., From ..... ft. to ..... ft.  
 GRAVEL PACK INTERVALS: From 20 ft. to 237 ft., From ..... ft. to ..... ft.  
 From ..... ft. to ..... ft., From ..... ft. to ..... ft.

6 GROUT MATERIAL: 1 Neat cement 2 Cement grout 3 Bentonite 4 Other .....  
 Grout Intervals: From 0 ft. to 20 ft., From ..... ft. to ..... ft., From ..... ft. to ..... ft.  
 What is the nearest source of possible contamination:  
 1 Septic tank 4 Lateral lines 7 Pit privy 10 Livestock pens 14 Abandoned water well  
 2 Sewer lines 5 Cess pool 8 Sewage lagoon 11 Fuel storage 15 Oil well/Gas well  
 3 Watertight sewer lines 6 Seepage pit 9 Feedyard 12 Fertilizer storage 16 Other (specify below)  
 13 Insecticide storage  
 Direction from well? West How many feet? 150'

FROM	TO	LITHOLOGIC LOG	FROM	TO	PLUGGING INTERVALS
0	2	Surface	113	120	Sandy Clay & Caliche
2	20	Loess	120	128	Sandy Clay & Caliche w/a few sand strks.
20	30	Sandy Clay w/Caliche			
30	45	Med. Sand & Gravel w/clay & Caliche Strks.	128	135	Med. Sand & Gravel w/Clay
			135	138.5	Cemented Sand w/Sand Strks.
45	56	Clay & Caliche	138.5	139	Cemented Sand
56	63	Fine to Med. Sand w/Clay & Caliche Strks.	139	152	Med. Sand & Gravel w/Sandstone & Clay Strks.
63	76	Med. Sand & Gravel w/a few Clay Lns.	152	160	Sandy Clay & Caliche w/sand
			160	179	Med. Sand & Gravel w/Clay
76	77	Caliche	179	181	Caliche, Sand Clay s/sand
77	110	Med. Sand w/clay Strks & some gravel	181	188	Cemented Sand w/few sand str.
			188	200	Fine to Med. Sand w/caliche
110	110.5	Cemented Sand	200	236	Med. Sand & Gravel w/a few
110.5	113	Med. Sand & Gravel	236	237	Shale Clay lysr.

7 CONTRACTOR'S OR LANDOWNER'S CERTIFICATION: This water well was (1) constructed, (2) reconstructed, or (3) plugged under my jurisdiction and was completed on (mo/day/year) 3-23-95 and this record is true to the best of my knowledge and belief. Kansas Water Well Contractor's License No. 554 This Water Well Record was completed on (mo/day/yr) 3-24-95 under the business name of Woofter Pump & Well, Inc. by (signature) Jay Flanagin