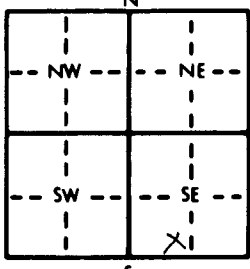
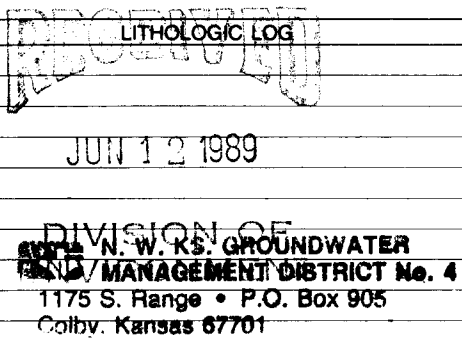


1 LOCATION OF WATER WELL: County: <u>Thomas</u>		Fraction: <u>SE 1/4 SW 1/4 SE 1/4</u>	Section Number: <u>2</u>	Township Number: <u>T 7 S</u>	Range Number: <u>R 31 E</u>	
Distance and direction from nearest town or city street address of well if located within city? <u>S. Main Street</u>						
2 WATER WELL OWNER: <u>Nell Kieffer</u>		RR#, St. Address, Box # : City, State, ZIP Code : <u>Refford, KS 67753</u>				
3 LOCATE WELL'S LOCATION WITH AN "X" IN SECTION BOX:		4 DEPTH OF COMPLETED WELL: <u>10.4</u> ft. ELEVATION: _____				
		Depth(s) Groundwater Encountered 1. _____ ft. 2. _____ ft. 3. _____ ft. _____ ft. WELL'S STATIC WATER LEVEL <u>Dry</u> ft. below land surface measured on mo/day/yr Pump test data: Well water was _____ ft. after _____ hours pumping _____ gpm Est. Yield _____ gpm: Well water was _____ ft. after _____ hours pumping _____ gpm Bore Hole Diameter _____ in. to _____ ft., and _____ in. to _____ ft. WELL WATER TO BE USED AS: 5 Public water supply 8 Air conditioning 11 Injection well ① Domestic 3 Feedlot 6 Oil field water supply 9 Dewatering 12 Other (Specify below) 2 Irrigation 4 Industrial 7 Lawn and garden only 10 Monitoring well Was a chemical/bacteriological sample submitted to Department? Yes _____ No _____; If yes, mo/day/yr sample was sub- mitted _____ Water Well Disinfected? Yes _____ No _____				
5 TYPE OF BLANK CASING USED: ① Steel 3 RMP (SR) 2 PVC 4 ABS		5 Wrought iron 8 Concrete tile 6 Asbestos-Cement 9 Other (specify below) 7 Fiberglass		CASING JOINTS: Glued _____ Clamped _____ Welded _____ Threaded _____		
Blank casing diameter <u>5</u> in. to <u>10.4</u> ft., Dia _____ in. to _____ ft., Dia _____ in. to _____ ft. Casing height above land surface <u>5</u> in., weight _____ lbs./ft. Wall thickness or gauge No. _____		TYPE OF SCREEN OR PERFORATION MATERIAL: 1 Steel 3 Stainless steel 5 Fiberglass 7 PVC 10 Asbestos-cement 2 Brass 4 Galvanized steel 6 Concrete tile 8 RMP (SR) 11 Other (specify) _____ 12 None used (open hole)				
SCREEN OR PERFORATION OPENINGS ARE: 1 Continuous slot 3 Mill slot 5 Gauzed wrapped 8 Saw cut 11 None (open hole) 2 Louvered shutter 4 Key punched 6 Wire wrapped 9 Drilled holes 7 Torch cut 10 Other (specify) _____		SCREEN-PERFORATED INTERVALS: From _____ ft. to _____ ft., From _____ ft. to _____ ft. From _____ ft. to _____ ft., From _____ ft. to _____ ft. GRAVEL PACK INTERVALS: From _____ ft. to _____ ft., From _____ ft. to _____ ft. From _____ ft. to _____ ft., From _____ ft. to _____ ft.				
6 GROUT MATERIAL: ① Neat cement 2 Cement grout 3 Bentonite 4 Other _____		Grout Intervals: From <u>4</u> ft. to <u>0</u> ft., From _____ ft. to _____ ft., From _____ ft. to _____ ft.				
What is the nearest source of possible contamination: 1 Septic tank 4 Lateral lines 7 Pit privy 2 Sewer lines 5 Cess pool 8 Sewage lagoon 3 Watertight sewer lines 6 Seepage pit 9 Feedyard		10 Livestock pens 14 Abandoned water well 11 Fuel storage 15 Oil well/Gas well 12 Fertilizer storage 16 Other (specify below) <u>None</u> 13 Insecticide storage				
Direction from well?		How many feet?				
FROM	TO	LITHOLOGIC LOG		FROM	TO	PLUGGING INTERVALS
				10.4	4	Clay-Sand Mix
				4	0	Neat Cement
7 CONTRACTOR'S OR LANDOWNER'S CERTIFICATION: This water well was (1) constructed, (2) reconstructed, or (3) plugged under my jurisdiction and was completed on (mo/day/year) <u>6-6-89</u> and this record is true to the best of my knowledge and belief. Kansas Water Well Contractor's License No. _____ This Water Well Record was completed on (mo/day/yr) <u>6-7-89</u> under the business name of _____ by (signature) <u>Kevin Beane</u>						