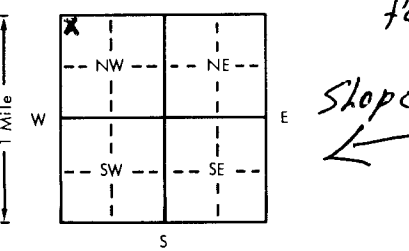


USE TYPEWRITER OR BALL
POINT PEN-PRESS FIRMLY,
PRINT CLEARLY.

WATER WELL RECORD
KSA 82a-1201-1215

Kansas Department of Health and
Environment-Division of Environment
(Water well Contractors)
Topeka, Kansas 66620

1. Location of well: County <u>Thomas</u>		Fraction <u>NW 1/4 NW 1/4 NW 1/4</u>	Section number <u>7</u>	Township number <u>T 7</u>	Range number <u>S R 31</u>
2. Distance and direction from nearest town or city: <u>GEM</u>			3. Owner of well: <u>Willard Cooper</u>		
Street address of well location if in city: <u>3 N 4 E</u>			R.R. or street: <u>Colby Kansas 67701</u>		
4. Locate with "X" in section below: 			6. Bore hole dia. <u>8</u> in. Completion date <u>6-20-79</u> Well depth <u>188</u> ft.		
			7. <input checked="" type="checkbox"/> Rotary <input type="checkbox"/> Driven <input type="checkbox"/> Dug <input type="checkbox"/> Hollow rod <input type="checkbox"/> Jetted <input type="checkbox"/> Bored <input type="checkbox"/> Reverse rotary		
			8. Use: <input type="checkbox"/> Domestic <input type="checkbox"/> Public supply <input type="checkbox"/> Industry <input type="checkbox"/> Irrigation <input type="checkbox"/> Air conditioning <input checked="" type="checkbox"/> Stock <input type="checkbox"/> Lawn <input type="checkbox"/> Oil field water <input type="checkbox"/> Other		
			9. Casing: Material <u>Plastic</u> Height: Above or below Threaded <input type="checkbox"/> Welded <input type="checkbox"/> Surface <u>12</u> in. RMP <input type="checkbox"/> PVC <input checked="" type="checkbox"/> Weight <u>15.8</u> lbs./ft. Dia. <u>5</u> in. to <u>152</u> ft. depth Wall Thickness: inches or Dia. <u>5</u> in. to <u>152</u> ft. depth Gauge No. <u>258</u>		
5. Type and color of material			From	To	10. Screen: Manufacturer's name <u>Peerless</u>
<u>Top Soil</u>			<u>0</u>	<u>4</u>	Type <u>Layer</u> Dia. <u>5</u>
<u>Clay</u>			<u>4</u>	<u>61</u>	Slot/gauze <u>1/8</u> Length <u>36</u>
<u>Sandy Clay, Sandstone</u>			<u>61</u>	<u>122</u>	Set between <u>152</u> ft. and <u>188</u> ft.
<u>M Gravel</u>			<u>122</u>	<u>130</u>	Gravel pack? <u>Yes</u> Size range of material <u>1/8</u>
<u>Sandy Clay, Sandstone</u>			<u>130</u>	<u>138</u>	11. Static water level: <u>115</u> ft. below land surface Date <u>6-19-79</u>
<u>M Gravel</u>			<u>138</u>	<u>146</u>	12. Pumping level below land surfaces: <u>160</u> ft. after <u>3</u> hrs. pumping <u>30</u> g.p.m. <u> </u> ft. after <u> </u> hrs. pumping <u> </u> g.p.m.
<u>Sandy Clay, Sandstone</u>			<u>146</u>	<u>170</u>	Estimated maximum yield <u>50</u> g.p.m.
<u>M Gravel</u>			<u>170</u>	<u>182</u>	13. Water sample submitted: <u> </u> mo./day/yr. <u>Yes</u> <input checked="" type="checkbox"/> No <input type="checkbox"/> Date <u> </u>
<u>Chrc</u>			<u>182</u>	<u>188</u>	14. Well head completion: <u> </u> Pitless adapter <u>12"</u> inches above grade
<u>Brock 182'</u>					15. Well grouted? <u>Yes</u> With: <input checked="" type="checkbox"/> Neat cement <input type="checkbox"/> Bentonite <input type="checkbox"/> Concrete Depth: From <u>5</u> ft. to <u>15</u> ft.
					16. Nearest source of possible contamination: <u>160</u> ft. Direction <u>West</u> Type <u>flooded</u>
					Well disinfected upon completion? <input checked="" type="checkbox"/> Yes <input type="checkbox"/> No
					17. Pump: <u>Not installed</u> Manufacturer's name <u>Red Jacket</u> Model number <u>112C</u> HP <u>3</u> Volts <u>230</u> Length of drop pipe <u>175</u> ft. capacity <u>30</u> g.p.m.
					Type: <input checked="" type="checkbox"/> Submersible <input type="checkbox"/> Turbine <input type="checkbox"/> Jet <input type="checkbox"/> Reciprocating <input type="checkbox"/> Centrifugal <input type="checkbox"/> Other
(Use a second sheet if needed)					
18. Elevation:		19. Remarks:		20. Water well contractor's certification: This well was drilled under my jurisdiction and this report is true to the best of my knowledge and belief. <u>Bill Chaffin</u> Business name <u> </u> License No. <u> </u> Address <u> </u> Signed <u> </u> Date <u>7-12-79</u>	

Forward the white, blue and pink copies to the Department of Health and Environment

Form WWC-5