


WATER WELL PLUGGING RECORD Form WWC-5P KSA 82a-1212 ID NO.

1 LOCATION OF WATER WELL: Fraction SW 1/4 SW 1/4 NW 1/4 SE 1/4 Section Number 21 Township Number T 7 S Range Number 32 E W
 County: Thomas

Street/Rural Address of Well Location; if unknown, distance & direction from nearest town or intersection: If at owner's address, check here 719 Main
Perm, KS 67734

Global Positioning Systems (GPS) Information:
 Latitude: 39.42728 (in decimal degrees)
 Longitude: 100.89657 (in decimal degrees)
 Elevation: _____
 Datum: WGS84, NAD83, NAD27
Collection Method:
 GPS unit (Make/Model: Garmin E-Trex 10)
 Digital Map/Photo, Topographic Map, Land Survey
 Est. Accuracy: <3 m, 3-5 m, 5-15 m, >15 m

2 WATER WELL OWNER: Paige Summers
 RR#, St. Address, Box #: 1740 W 6th
 City, State ZIP Code: Colby KS 67701

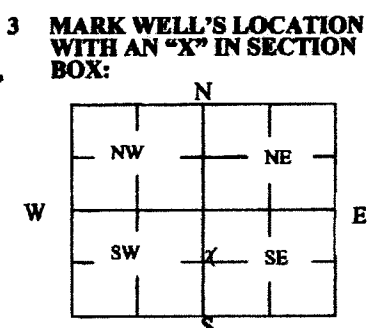

4 DEPTH OF WELL 152 ft.
WELL'S STATIC WATER LEVEL Dry ft
WELL WAS USED AS:
 Domestic Irrigation Public Water Supply Dewatering
 Feedlot Oil Field Water Supply Monitoring
 Industrial Domestic (Lawn & Garden) Injection Well
 Air Conditioning Other _____
 Was a chemical/bacteriological sample submitted to Department? Yes No

5 TYPE OF BLANK CASING USED:
 Steel RMP (SR) Wrought Fiberglass Other (Specify below)
 PVC ABS Asbestos-Cement Concrete Tile
 Blank casing diameter 5' in. Was casing pulled? Yes No If yes, how much 64'
 Casing height above or (below) land surface 828 in. or 69'

6 GROUT PLUG MATERIAL: Neat cement Cement grout Bentonite Other _____
 Grout Plug Intervals: From 152 ft to 48 ft, From 9 ft to 6 ft, From 6 ft to 5 ft.
Bentonite Bentonite Cement Grout Cap
 What is the nearest source of possible contamination:
 Septic tank Seepage pit Fuel storage Other (specify below)
 Sewer lines Pit privy Fertilizer storage
 Watertight sewer lines Sewage lagoon Insecticide storage
 Lateral lines Feedyard Abandoned water well Direction from well? E
 Cess pool Livestock pens Oil well/Gas well How many feet? 40'

| FROM | TO | PLUGGING MATERIALS | FROM | TO | PLUGGING MATERIALS |
|------|----|--------------------------|------|----|--------------------|
| 152 | 48 | Bentonite | | | |
| 48 | 9 | Clay | | | |
| 9 | 6 | Bentonite | | | |
| 6 | 5 | Cement Grout Cap | | | |
| 5 | 0 | Compacted Clay + Topsoil | | | |

7 CONTRACTOR'S OR LANDOWNER'S CERTIFICATION: This water well was plugged under my jurisdiction and was completed on (mo/day/year) 5-17-16 and this record is true to the best of my knowledge and belief. Kansas Water Well Contractor's License No. 663. This Water Well Record was completed on (mo/day/year) 5-18-16 under the business name of Brenn Pump & Supply by (signature) _____

INSTRUCTIONS: Use typewriter or ballpoint pen. Please press firmly and print clearly. Please fill in blanks, underline or circle the correct answers. Send top three copies to Kansas Department of Health and Environment, Bureau of Water, Geology Section, 1000 SW Jackson St., Ste. 420, Topeka, Kansas 66612-1367. Telephone: 785/296-5524. Send one to Water Well Owner and retain one for your records. Visit us at <http://www.kdheks.gov/waterwell/index.html>.

E-Mailed 40 Blue Benton 5-23-16 C