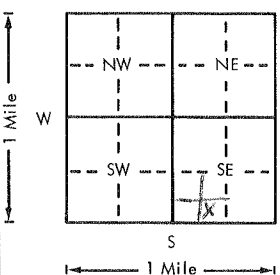
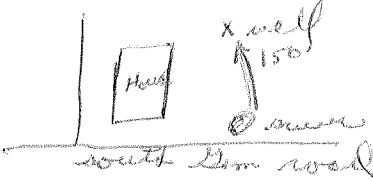


USE TYPEWRITER OR BALL  
POINT PEN-PRESS FIRMLY,  
PRINT CLEARLY.

WATER WELL RECORD  
KSA 82a-1201-1215

Kansas Department of Health and  
Environment-Division of Environment  
(Water well Contractors)  
Topeka, Kansas 66620

1. Location of well:	County <u>Thomas</u>	Fraction <u>SE 1/4 SW 1/4 SE 1/4</u>	Section number <u>21</u>	Township number <u>T 7 S</u>	Range number <u>R 32 E (W)</u>
2. Distance and direction from nearest town or city: <u>no steel run</u>		3. Owner of well: <u>W. William Treat</u>			
Street address of well location if in city: <u>South side of Shunk</u>		R.R. or street: <u>Perm, Ks.</u>			
City, state, zip code:					
4. Locate with "X" in section below:		Sketch map:		6. Bore hole dia. <u>9</u> in. Completion date <u>8-30-80</u> Well depth <u>240</u> ft.	
				7. <input checked="" type="checkbox"/> Cable tool <input checked="" type="checkbox"/> Rotary <input type="checkbox"/> Driven <input type="checkbox"/> Dug <input type="checkbox"/> Hollow rod <input type="checkbox"/> Jetted <input type="checkbox"/> Bored <input type="checkbox"/> Reverse rotary	
5. Type and color of material		From		To	
<u>Top soil</u>		<u>0</u>		<u>27</u>	
<u>Sandy clay</u>		<u>27</u>		<u>55</u>	
<u>M. gravel</u>		<u>55</u>		<u>62</u>	
<u>Sandy clay</u>		<u>62</u>		<u>99</u>	
<u>Fine sand M. gravel</u>		<u>99</u>		<u>110</u>	
<u>Sandy clay</u>		<u>110</u>		<u>126</u>	
<u>Sand stone</u>		<u>126</u>		<u>129</u>	
<u>M gravel, gravel</u>		<u>129</u>		<u>135</u>	
<u>Sand stone</u>		<u>135</u>		<u>142</u>	
<u>Fine sand</u>		<u>142</u>		<u>149</u>	
<u>Sand stone</u>		<u>149</u>		<u>153</u>	
<u>Sandy clay</u>		<u>153</u>		<u>160</u>	
<u>Fine sand</u>		<u>160</u>		<u>171</u>	
<u>Sandy clay</u>		<u>171</u>		<u>187</u>	
<u>M gravel, gravel</u>		<u>187</u>		<u>207</u>	
<u>Fine sand</u> (Use a second sheet if needed)		<u>207</u>		<u>214</u>	
18. Elevation:		19. Remarks: <u>M gravel - 214 - 238</u> <u>Shale 238 - 240</u>			
Topography: <input type="checkbox"/> Hill <input type="checkbox"/> Slope <input checked="" type="checkbox"/> Upland <input type="checkbox"/> Valley		20. Water well contractor's certification: This well was drilled under my jurisdiction and this report is true to the best of my knowledge and belief. <u>B+B Drilling</u> <u>376</u> Business name License No. Address <u>Perm, Ks.</u> Signed <u>Joseph B. Beckman</u> Date <u>9-15-80</u> Authorized representative			

Forward the white, blue and pink copies to the Department of Health and Environment

Form WWC-5