


Distance and direction from nearest town or city street address of well if located within city?

WATER WELL OWNER: Curtis L & Wilma L Brockway
 #, St. Address, Box # : P.O. Box 246

LOCATE WELL'S LOCATION WITH AN "X" IN SECTION BOX: 4 DEPTH OF COMPLETED WELL: 200 ft. ELEVATION: 1000 ft.


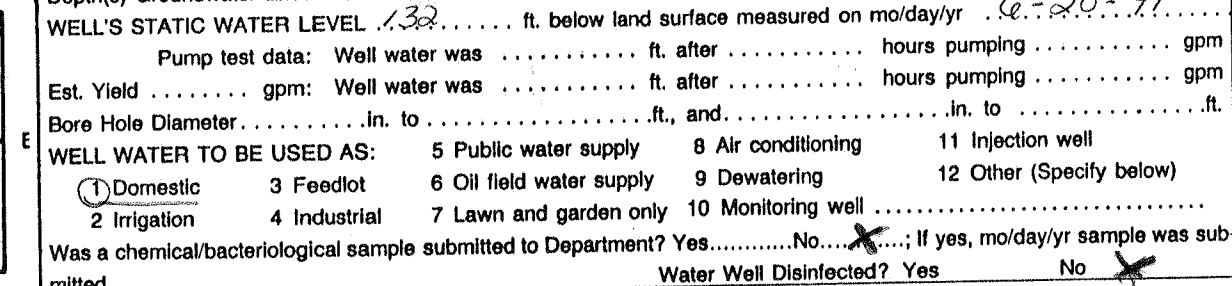

① Steel	3 RMP (SR)	6 Asbestos-Cement	9 Other (specify below)
2 PVC	4 ABS	7 Fiberglass

PE OF SCREEN OR PERFORATION MATERIAL:

7 PVC	10 Asbestos-cement
8 RMP (SP)	11 Other (specify) <i>NA</i>

SCREEN OR PERFORATION OPENINGS ARE:

1 Continuous slot	2 Mill slot	3 Gauzed wrapped	4 Wire wrapped	5 Saw cut	6 None (open hole)

GREEN-PERFORATED INTERVALS: From ft. to ft., From ft. to ft.
From ft. to ft., From ft. to ft.

GROUT MATERIAL: 1 Neat cement ② Cement grout ③ Bentonite 4 Other

1 Septic tank	4 Lateral lines	7 Pit privy	11 Fuel storage	15 Oil well/Gas well
2 Sewage lagoon	5 Manure storage	8 Other (specify below)	12 Fertilizer storage	16 Other (specify below)

Direction from well?		LITHOLOGIC LOG	How many feet?		PLUGGING INTERVALS
FROM	TO		FROM	TO	

CONTRACTOR'S OR LANDOWNER'S CERTIFICATION: This water well was (1) constructed, (2) reconstructed, or (3) plugged under my jurisdiction and was completed on (mo/day/year) 6-20-91 and this record is true to the best of my knowledge and belief. Kansas Water Well Contractor's License No. _____ This Water Well Record was completed on (mo/day/yr) 6-25-91 under the business name of _____ by (signature) [Signature]

100