


1 LOCATION OF WATER WELL:	Fraction	Section Number	Township Number	Range Number
County: Thomas	SE ¼ NW ¼ SE ¼	31	T 7 S	R 33 EW

Distance and direction from nearest town or city street address of well if located within city?

Colby, KS HWY 24 Directly east of Village Laundromat Well #PMW - 5

2 WATER WELL OWNER: KDHE Div of Env. Bureau of Env. Remediation	
RR#, St. Address, Box # :	Forbes Field, Building 740 T. Winn
City, State, ZIP Code :	Topeka, KS 66620 - 0001
	Board of Agriculture, Division of Water Resources
	Application Number:

3 LOCATE WELL'S LOCATION WITH AN "X" IN SECTION BOX: 4 DEPTH OF COMPLETED WELL: 135.0 ft. ELEVATION: NA

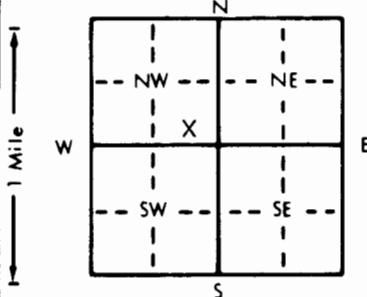

4) DEPTH OF COMPLETED WELL.....135.0..... ft. ELEVATION:NA.....

Depth(s) Groundwater Encountered 1..... ft. 2..... ft. 3..... ft.

WELL'S STATIC WATER LEVEL99.51..... ft. below land surface measured on mo/day/yr5/26/95.....

Pump test data: Well water was ft. after hours pumping gpm

Est. Yield0.1..... gpm: Well water was ft. after hours pumping gpm

Bore Hole Diameter...7.75... in. to135..... ft., and..... in. to ft.

WELL WATER TO BE USED AS:

1 Domestic	3 Feedlot	6 Oil field water supply	9 Dewatering	12 Other (Specify below)
2 Irrigation	4 Industrial	7 Lawn and garden only	10 Monitoring well	

Was a chemical/bacteriological sample submitted to Department? Yes.....No...X.....; If yes, mo/day/yr sample was submitted

Water Well Disinfected? Yes.....No...X.....

5	TYPE OF BLANK CASING USED:		5 Wrought iron	8 Concrete tile	CASING JOINTS: Glued Clamped Welded Threaded
	1 Steel	3 RMP (SR)	6 Asbestos-Cement	9 Other (specify below)	
	2 PVC	4 ABS	7 Fiberglass		

Blank casing diameter . . . 4 . . . in. to . . . 95.0 . . ft. Dia . . . in. to . . . ft. Dia . . . in. to . . . ft.
Casing height above land surface . . (-0.5) -6.0 . in., weight . . . lbs./ft. Wall thickness or gauge No. Sch. 40 . . .

TYPE OF SCREEN OR PERFORATION MATERIAL:			7 PVC	10 Asbestos-cement
1 Steel	3 Stainless steel	5 Fiberglass	8 RMP (SR)	11 Other (specify)
2 Brass	4 Galvanized steel	6 Concrete tile	9 ABS	12 None used (open hole)

SCREEN OR PERFORATION OPENINGS ARE:

1 Continuous slot	3 Mill slot	0.01"	5 Gauzed wrapped	8 Saw cut	11 None (open hole)
2 Louvered shutter	4 Key punched		6 Wire wrapped	9 Drilled holes	
			7 Torch cut	10 Other (specify)	

SCREEN-PERFORATED INTERVALS:	From . . . 95.0 . . .	ft. to . . . 130.0 . . .	ft., From . . .	ft. to . . .	ft.
	From . . .	ft. to . . .	ft., From . . .	ft. to . . .	ft.
GRAVEL PACK INTERVALS:	From . . . 135.0 . . .	ft. to . . . 92.0 . . .	ft., From . . .	ft. to . . .	ft.
	From . . .	ft. to . . .	ft., From . . .	ft. to . . .	ft.

6 GROUT MATERIAL: 1 Neat cement 2 Cement grout 3 Bentonite 4 Other
Grout Intervals: 3 From 92 ft. to 10 ft. 2 From 10 ft. to 00 ft. From ft. to ft.

What is the nearest source of possible contamination:			10 Livestock pens	14 Abandoned water well
1 Septic tank	4 Lateral lines	7 Pit privy	11 Fuel storage	15 Oil well/Gas well
<u>2 Sewer lines</u>	5 Cess pool	8 Sewage lagoon	12 Fertilizer storage	16 Other (specify below)
<u>3 Watertight sewer lines</u>	6 Seepage pit	9 Feedyard	13 Insecticide storage	

Direction from well?	How many feet?	10.0
----------------------	----------------	------

[illegible]

7 CONTRACTOR'S OR LANDOWNER'S CERTIFICATION: This water well was (1) constructed, (2) reconstructed, or (3) plugged under my jurisdiction and was completed on (mo/day/year) 5/24/95 and this record is true to the best of my knowledge and belief. Kansas Water Well Contractor's License No. 549 This Water Well Record was completed on (mo/day/yr) 6/1/95 under the business name of J S R Drilling Services, Inc. by (signature) Raymond Coons