


1 LOCATION OF WATER WELL: County: Thomas	Fraction SE ¼ SW ¼ NE ¼	Section Number 31	Township Number T 7 S	Range Number R 33 E (W)
---	----------------------------	----------------------	--------------------------	----------------------------

Distance and direction from nearest town or city street address of well if located within city?
Jerry's Repair Hwy 24 S Court Avenue Well #3MW - 4

2 WATER WELL OWNER: KDHE Div. of Env. Bureau of Env. Remediation		
RR#, St. Address, Box # :	Forbes Field, Building 740 T. Winn	Board of Agriculture, Division of Water Resources
City, State, ZIP Code :	Topeka, KS 66620 - 0001	Application Number:

3	LOCATE WELL'S LOCATION WITH AN "X" IN SECTION BOX:	4	DEPTH OF COMPLETED WELL.....136.0	ft.	ELEVATION: NA
			Depth(s) Groundwater Encountered: 1	ft. 2	ft. 3

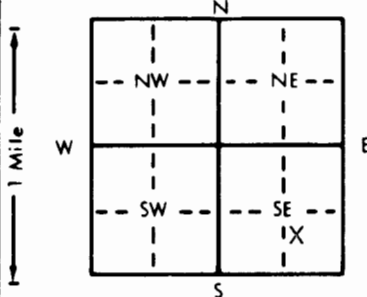

4) DEPTH OF COMPLETED WELL..... 136.0 ft. ELEVATION: NA

Depth(s) Groundwater Encountered 1. ft. 2. ft. 3. ft.

WELL'S STATIC WATER LEVEL 98.97 ft. below land surface measured on mo/day/yr 5/25/95

Pump test data: Well water was ft. after hours pumping gpm

Est. Yield 5 - 7 gpm: Well water was ft. after hours pumping gpm

Bore Hole Diameter..... 7.75 in. to 135.0 ft., and..... in. to ft.

WELL WATER TO BE USED AS:

5 Public water supply	8 Air conditioning	11 Injection well
1 Domestic	3 Feedlot	6 Oil field water supply
2 Irrigation	4 Industrial	7 Lawn and garden only
		10 Monitoring well

Was a chemical/bacteriological sample submitted to Department? Yes.....No.....X.....; If yes, mo/day/yr sample was submitted

Water Well Disinfected? Yes.....No.....X.....

5	TYPE OF BLANK CASING USED:		5 Wrought iron	8 Concrete tile	CASING JOINTS: Glued Clamped Welded Threaded
	1 Steel	3 RMP (SR)	6 Asbestos-Cement	9 Other (specify below)	
	2 PVC	4 ABS	7 Fiberglass		

Blank casing diameter . . . 4.0 . . . in. to . . . 95.0 . . . ft. Dia . . . in. to . . . ft. Dia . . . in. to . . . ft.
Casing height above land surface . . . (-0.5) -5.0 . . . in. weight . . . lbs./ft. Wall thickness or gauge No. Sch. 40

TYPE OF SCREEN OR PERFORATION MATERIAL:				
1 Steel	3 Stainless steel	5 Fiberglass	7 <u>PVC</u>	10 Asbestos-cement
2 Brass	4 Galvanized steel	6 Concrete tile	8 RMP (SR)	11 Other (specify)
			9 ABS	12 None used (open hole)

SCREEN OR PERFORATION OPENINGS ARE:		5 Gauzed wrapped	8 Saw cut	11 None (open hole)
1 Continuous slot	<u>3 Mill slot</u> $\square \cdot \square 1''$	6 Wire wrapped	9 Drilled holes	
2 Louvered shutter	4 Key punched	7 Torch cut	10 Other (specify)	

SCREEN-PERFORATED INTERVALS:	From	95.0	ft. to	130.0	ft.,	From		ft. to		ft.
	From		ft. to		ft.,	From		ft. to		ft.
GRAVEL PACK INTERVALS:	From	92.0	ft. to	135.0	ft.,	From		ft. to		ft.
	From		ft. to		ft.,	From		ft. to		ft.

6 GROUT MATERIAL: 1 Neat cement 2 Cement grout 3 Bentonite 4 Other
Grout Intervals: 3 From . 92 . ft. to . 10 . ft., 2 From . 10 . ft. to . 0 . ft., From . ft. to . ft.

What is the nearest source of possible contamination:			10 Livestock pens	14 Abandoned water well
1 Septic tank	4 Lateral lines	7 Pit privy	11 Fuel storage	15 Oil well/Gas well
<u>2 Sewer lines</u>	5 Cess pool	8 Sewage lagoon	12 Fertilizer storage	16 Other (specify below)
<u>3 Watertight sewer lines</u>	6 Seepage pit	9 Feedyard	13 Insecticide storage	

Direction from well? _____ How many feet? 10.0

[illegible]

7 CONTRACTOR'S OR LANDOWNER'S CERTIFICATION: This water well was (1) constructed, (2) reconstructed, or (3) plugged under my jurisdiction and was completed on (mo/day/year) 5/23/95 and this record is true to the best of my knowledge and belief. Kansas Water Well Contractor's License No. 549 This Water Well Record was completed on (mo/day/yr) 6/1/95 under the business name of J & R Drilling Services, Inc. by (signature) Raymond Coors