

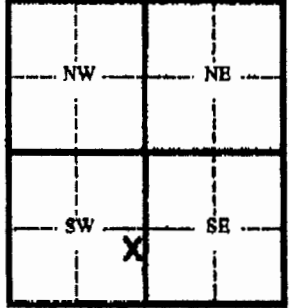
## WATER WELL PLUGGING RECORD

Form WWC-5P

KSA 82a-1212

ID No.

AS-01

1 LOCATION OF WATER WELL: County: <u>Thomas</u>	Fraction <u>NE 1/4 SE 1/4 SW 1/4</u>	Section Number <u>31</u>	Township Number <u>7S</u>	Range Number <u>33W</u>																																				
Distance and direction from nearest town or city street address of well if located within city? <u>190 W. 4th, Colby, KS</u>	
2 WATER WELL OWNER: <u>Pyramid Oil</u> RR#, St. Address, Box # City, State, ZIP Code <u>Colby, KS 67701</u> Board of Agriculture, Division of Water Resources Application Number:	
3 MARK WELL'S LOCATION WITH AN "X" IN SECTION BOX: <div style="text-align: center;">  </div>		4 DEPTH OF WELL <u>130</u> ft. WELL'S STATIC WATER LEVEL _____ ft. WELL WAS USED AS: <div style="display: flex; justify-content: space-between;"> <div> 1 Domestic 2 Irrigation 3 Feedlot 4 Industrial </div> <div> 5 Public Water Supply 6 Oil Field Water Supply 7 Lawn and Garden (domestic) 8 Air Conditioning </div> <div> 9 Dewatering 10 Monitoring Well 11 <u>Injection Well</u> 12 Other _____ </div> </div> Was a chemical/bacteriological sample submitted to Department? Yes _____ No _____ If yes, mo/day/yr sample was submitted _____ Water Well Disinfected: Yes _____ No _____																																						
5 TYPE OF BLANK CASING USED: 1 Steel      3 RMP (SR)      5 Wrought      7 Fiberglass      9 Other (specify below) 2 <u>PVC</u> 4 ABC      6 Asbestos-Cement      8 Concrete Tile Blank casing diameter <u>2</u> in. Was casing pulled? Yes <u>X</u> No _____ If yes, how much <u>3 ft</u> Casing height above or below land surface <u>-36</u> in.	
6 GROUT PLUG MATERIAL: 1 Neat cement    2 Cement grout    3 <u>Bentonite</u> 4 Other <u>well sand</u> Grout Plug Intervals From <u>115</u> ft. to <u>0</u> ft. From <u>115</u> ft. to <u>130</u> ft. From _____ ft. to _____ ft. What is the nearest source of possible contamination: <div style="display: flex; justify-content: space-between;"> <div> 1 Septic tank 2 Sewer lines 3 Watertight sewer lines 4 Lateral lines 5 Cess Pool </div> <div> 6 Seepage pit 7 Pit privy 8 Sewage lagoon 9 Feedyard 10 Livestock pens </div> <div> 11 <u>Fuel storage</u> 12 Fertilizer storage 13 Insecticide storage 14 Abandoned water well 15 Oil well/ Gas well </div> <div> 16 Other (specify below) _____ </div> </div> Direction from well? _____ How many feet? _____	
<table border="1" style="width:100%; border-collapse: collapse;"> <thead> <tr> <th style="width:10%;">FROM</th> <th style="width:10%;">TO</th> <th style="width:10%;">CODE</th> <th style="width:70%;">PLUGGING MATERIALS</th> </tr> </thead> <tbody> <tr> <td>0</td> <td>115</td> <td></td> <td>Bentonite grout</td> </tr> <tr> <td>115</td> <td>130</td> <td></td> <td>Well Sand</td> </tr> <tr><td> </td><td> </td><td> </td><td> </td></tr> <tr><td> </td><td> </td><td> </td><td> </td></tr> <tr><td> </td><td> </td><td> </td><td> </td></tr> <tr><td> </td><td> </td><td> </td><td> </td></tr> <tr><td> </td><td> </td><td> </td><td> </td></tr> <tr><td> </td><td> </td><td> </td><td> </td></tr> </tbody> </table>					FROM	TO	CODE	PLUGGING MATERIALS	0	115		Bentonite grout	115	130		Well Sand																								
FROM	TO	CODE	PLUGGING MATERIALS																																					
0	115		Bentonite grout																																					
115	130		Well Sand																																					
7 CONTRACTOR'S OR LANDOWNER'S CERTIFICATION: This water well was plugged under my jurisdiction and was completed on (mo/day/yr) <u>7/17/08</u> and this record is true to the best of my knowledge and belief. Kansas Water Well Contractor's License No. <u>554</u> This Water Well Record was completed on (mo/day/yr) <u>7/29/08</u> under the business name of <u>Nick Holt</u> <u>Bluestem Environmental Engineering, Inc.</u> by (signature) _____	
INSTRUCTIONS: Please fill in blanks and circle the correct answers. Send three copies to Kansas Department of Health and Environment, Bureau of Water, 1000 S W Jackson St., Ste. 420, Topeka, Kansas 66620-0001. Telephone: 785-298-3585. Send one to Water Well Owner and retain one for your records.	

RECEIVED

JAN 08 2009

BUREAU OF WATER