

WATER WELL PLUGGING RECORD

Form WWC-5P

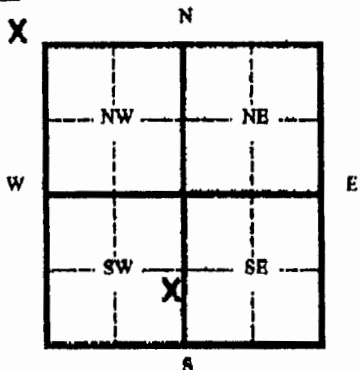
KSA 82a-1212

ID No.

MW-03

1 LOCATION OF WATER WELL: Fraction NE $\frac{1}{4}$ SE $\frac{1}{4}$ SW $\frac{1}{4}$ Section Number 31 Township Number 7S Range Number 33W
County: Thomas
Distance and direction from nearest town or city street address of well if located within city?
190 W. 4th, Colby, KS

2 WATER WELL OWNER: Pyramid Oil
RR#, St. Address, Box #
City, State, ZIP Code: Colby, KS 67701
Board of Agriculture, Division of Water Resources
Application Number:

3 MARK WELL'S LOCATION WITH AN "X" IN SECTION BOX:


4 DEPTH OF WELL 125 ft.
WELL'S STATIC WATER LEVEL 112 ft.
WELL WAS USED AS:
 1 Domestic 5 Public Water Supply 9 Dewatering
 2 Irrigation 6 Oil Field Water Supply 10 Monitoring Well
 3 Feedlot 7 Lawn and Garden (domestic) 11 Injection Well
 4 Industrial 8 Air Conditioning 12 Other
 Was a chemical/bacteriological sample submitted to Department? Yes No
 If yes, mo/day/yr sample was submitted
 Water Well Disinfected: Yes No

5 TYPE OF BLANK CASING USED:
 1 Steel 3 RMP (SR) 5 Wrought 7 Fiberglass 9 Other (specify below)
 2 PVC 4 ABC 6 Asbestos-Cement 8 Concrete Tile
 Blank casing diameter 4 in. Was casing pulled? Yes No If yes, how much 3 ft
 Casing height above or below land surface -36 in.

6 GROUT PLUG MATERIAL: 1 Neat cement 2 Cement grout 3 Bentonite 4 Other well Sand
 Grout Plug Intervals From 95 ft. to 0 ft. From 95 ft. to 125 ft. From ft. to ft.
 What is the nearest source of possible contamination:
 1 Septic tank 6 Seepage pit 11 Fuel storage 16 Other (specify below)
 2 Sewer lines 7 Pit privy 12 Fertilizer storage
 3 Watertight sewer lines 8 Sewage lagoon 13 Insecticide storage
 4 Lateral lines 9 Feedyard 14 Abandoned water well
 5 Cess Pool 10 Livestock pens 15 Oil well/ Gas well
 Direction from well? How many feet?

FROM	TO	CODE	PLUGGING MATERIALS
0	95		Bentonite grout
95	125		Well Sand

7 CONTRACTOR'S OR LANDOWNER'S CERTIFICATION: This water well was plugged under my jurisdiction and was completed on (mo/day/yr) 7/17/08 and this record is true to the best of my knowledge and belief. Kansas Water Well Contractor's License No. 554 This Water Well Record was completed on (mo/day/yr) 7/29/08 under the business name of Nulldht Bluestem Environmental Engineering, Inc.
by (signature)

INSTRUCTIONS: Please fill in blanks and circle the correct answers. Send three copies to Kansas Department of Health and Environment, Bureau of Water, 1000 S W Jackson St., Ste. 420, Topeka, Kansas 66626-0001. Telephone: 785-298-3585. Send one to Water Well Owner and retain one for your records.

RECEIVED

JAN 08 2009

BUREAU OF WATER