

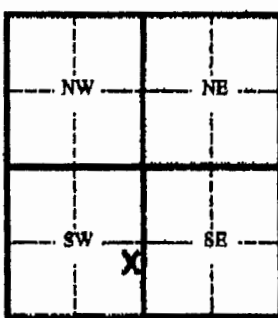
## WATER WELL PLUGGING RECORD

Form WWC-5P

KSA 82a-1212

ID No.

MW-17

1 LOCATION OF WATER WELL:		Fraction	Section Number	Township Number	Range Number																																				
County: Thomas		NE $\frac{1}{4}$ SE $\frac{1}{4}$ SW $\frac{1}{4}$	31	7S	33W																																				
Distance and direction from nearest town or city street address of well if located within city? 190 W. 4th, Colby, KS	
2 WATER WELL OWNER: Pyramid Oil	
RR#, St. Address, Box #			Board of Agriculture, Division of Water Resources																																						
City, State, ZIP Code: Colby, KS 67701			Application Number:																																						
3 MARK WELL'S LOCATION WITH AN "X" IN SECTION BOX:		4 DEPTH OF WELL 125 ft.																																							
		WELL'S STATIC WATER LEVEL _____ ft.																																							
		WELL WAS USED AS:																																							
		1 Domestic 5 Public Water Supply 9 Dewatering																																							
		2 Irrigation 8 Oil Field Water Supply 10 Monitoring Well																																							
		3 Feedlot 7 Lawn and Garden (domestic) 11 Injection Well																																							
		4 Industrial 8 Air Conditioning 12 Other _____																																							
		Was a chemical/bacteriological sample submitted to Department? Yes _____ No _____																																							
		If yes, mo/day/yr sample was submitted _____																																							
		Water Well Disinfected: Yes _____ No _____																																							
5 TYPE OF BLANK CASING USED:	
1 Steel 3 RMP (SR) 5 Wrought 7 Fiberglass 9 Other (specify below)	
2 PVC 4 ABC 6 Asbestos-Cement 8 Concrete Tile	
Blank casing diameter 4 in. Was casing pulled? Yes <input checked="" type="checkbox"/> No _____ If yes, how much 3 ft	
Casing height above or below land surface -36 in.	
6 GROUT PLUG MATERIAL: 1 Neat cement 2 Cement grout 3 Bentonite 4 Other Well Sand	
Grout Plug Intervals From 95 ft. to 0 ft. From 95 ft. to 125 ft. From _____ ft. to _____ ft.	
What is the nearest source of possible contamination:	
1 Septic tank 6 Seepage pit 11 Fuel storage 16 Other (specify below)	
2 Sewer lines 7 Pit privy 12 Fertilizer storage	
3 Watertight sewer lines 8 Sewage lagoon 13 Insecticide storage	
4 Lateral lines 9 Feedyard 14 Abandoned water well	
5 Cess Pool 10 Livestock pens 15 Oil well/ Gas well	
Direction from well? _____ How many feet? _____	
<table border="1"><thead><tr><th>FROM</th><th>TO</th><th>CODE</th><th>PLUGGING MATERIALS</th></tr></thead><tbody><tr><td>0</td><td>95</td><td></td><td>Bentonite grout</td></tr><tr><td>95</td><td>125</td><td></td><td>Well Sand</td></tr><tr><td> </td><td> </td><td> </td><td> </td></tr><tr><td> </td><td> </td><td> </td><td> </td></tr><tr><td> </td><td> </td><td> </td><td> </td></tr><tr><td> </td><td> </td><td> </td><td> </td></tr><tr><td> </td><td> </td><td> </td><td> </td></tr><tr><td> </td><td> </td><td> </td><td> </td></tr></tbody></table>						FROM	TO	CODE	PLUGGING MATERIALS	0	95		Bentonite grout	95	125		Well Sand																								
FROM	TO	CODE	PLUGGING MATERIALS																																						
0	95		Bentonite grout																																						
95	125		Well Sand																																						
7 CONTRACTOR'S OR LANDOWNER'S CERTIFICATION: This water well was plugged under my jurisdiction and was completed on (mo/day/yr) 7/17/08 and this record is true to the best of my knowledge and belief. Kansas Water Well Contractor's License No. 554 This Water Well Record was completed on (mo/day/yr) 7/29/08 under the business name of Bluestem Environmental Engineering, Inc. by (signature) <i>Niddht</i> <i>David W. W...</i>	
INSTRUCTIONS: Please fill in blanks and circle the correct answers. Send three copies to Kansas Department of Health and Environment, Bureau of Water, 1000 S W Jackson St., Ste. 420, Topeka, Kansas 66620-0001. Telephone: 785-298-3586. Send one to Water Well Owner and retain one for your records.	