

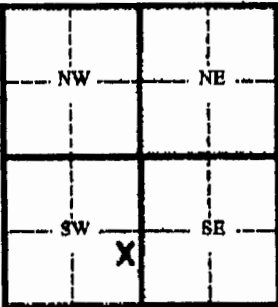
WATER WELL PLUGGING RECORD

Form WWC-5P

KSA 82a-1212

ID No.

SVE-02

1 LOCATION OF WATER WELL:	Fraction	Section Number	Township Number	Range Number																																
County: Thomas	NE ¼ SE ¼ SW ¼	31	7S	33W																																
Distance and direction from nearest town or city street address of well if located within city? 190 W. 4th, Colby, KS																																				
2 WATER WELL OWNER: Pyramid Oil																																				
RR#, St. Address, Box #		Board of Agriculture, Division of Water Resources																																		
City, State, ZIP Code : Colby, KS 67701		Application Number:																																		
3 MARK WELL'S LOCATION WITH AN "X" IN SECTION BOX:		4 DEPTH OF WELL 50 ft.																																		
<div style="text-align: center;"> N  S </div>		WELL'S STATIC WATER LEVEL _____ ft. WELL WAS USED AS: <div style="display: flex; justify-content: space-between;"> <div> 1 Domestic 2 Irrigation 3 Feedlot 4 Industrial </div> <div> 5 Public Water Supply 6 Oil Field Water Supply 7 Lawn and Garden (domestic) 8 Air Conditioning </div> <div> 9 Dewatering 10 Monitoring Well 11 Injection Well 12 Other _____ Soil Vapor </div> </div>																																		
5 TYPE OF BLANK CASING USED: 1 Steel 3 RMP (SR) 5 Wrought 7 Fiberglass 9 Other (specify below) ② PVC 4 ABC 6 Asbestos-Cement 8 Concrete Tile Blank casing diameter 4 in. Was casing pulled? Yes <input checked="" type="checkbox"/> No _____ If yes, how much 3 ft Casing height above or below land surface -36 in.																																				
6 GROUT PLUG MATERIAL: 1 Neat cement 2 Cement grout ③ Bentonite ④ Other well Sand Grout Plug Intervals From 0 ft. to 40 ft. From 40 ft. to 50 ft. From _____ ft. to _____ ft. What is the nearest source of possible contamination: <div style="display: flex; justify-content: space-between;"> <div> 1 Septic tank 2 Sewer lines 3 Watertight sewer lines 4 Lateral lines 5 Cess Pool </div> <div> 6 Seepage pit 7 Pit privy 8 Sewage lagoon 9 Feedyard 10 Livestock pens </div> <div> ⑪ Fuel storage 12 Fertilizer storage 13 Insecticide storage 14 Abandoned water well 15 Oil well/ Gas well </div> <div> 16 Other (specify below) _____ </div> </div> Direction from well? _____ How many feet? _____																																				
<table border="1" style="width:100%; border-collapse: collapse;"> <thead> <tr> <th>FROM</th> <th>TO</th> <th>CODE</th> <th>PLUGGING MATERIALS</th> </tr> </thead> <tbody> <tr> <td>0</td> <td>40</td> <td></td> <td>Bentonite grout</td> </tr> <tr> <td>40</td> <td>50</td> <td></td> <td>Well Sand</td> </tr> <tr><td> </td><td> </td><td> </td><td> </td></tr> <tr><td> </td><td> </td><td> </td><td> </td></tr> <tr><td> </td><td> </td><td> </td><td> </td></tr> <tr><td> </td><td> </td><td> </td><td> </td></tr> <tr><td> </td><td> </td><td> </td><td> </td></tr> </tbody> </table>					FROM	TO	CODE	PLUGGING MATERIALS	0	40		Bentonite grout	40	50		Well Sand																				
FROM	TO	CODE	PLUGGING MATERIALS																																	
0	40		Bentonite grout																																	
40	50		Well Sand																																	
7 CONTRACTOR'S OR LANDOWNER'S CERTIFICATION: This water well was plugged under my jurisdiction and was completed on (mo/day/yr) 7/17/08 and this record is true to the best of my knowledge and belief. Kansas Water Well Contractor's License No. 554 This Water Well Record was completed on (mo/day/yr) 7/29/08 under the business name of Nuclinet Bluestem Environmental Engineering, Inc. by (signature) <i>[Signature]</i>																																				
INSTRUCTIONS: Please fill in blanks and circle the correct answers. Send three copies to Kansas Department of Health and Environment, Bureau of Water, 1000 S W Jackson St., Ste. 420, Topeka, Kansas 66620-0001. Telephone: 785-298-3585. Send one to Water Well Owner and retain one for your records.																																				