

WATER WELL PLUGGING RECORD Form WWC-5P KSA 82a-1212 ID NO.

1 **LOCATION OF WATER WELL:** Fraction NE 1/4 SW 1/4 NW 1/4 NW 1/4 Section Number 31 Township Number T 7 S Range Number 33 E W
 County: Thomas


Street/Rural Address of Well Location; if unknown, distance & direction from nearest town or intersection: If at owner's address, check here

Global Positioning Systems (GPS) information:
 Latitude: 39.40673 (in decimal degrees)
 Longitude: 101.05319 (in decimal degrees)
 Elevation: _____
 Horizontal Datum: WGS84, NAD83, NAD27
 Collection Method: _____

2 **WATER WELL OWNER:** Ron + Melony Shelz
 RR#, St. Address, Box #: 2 De Soto Dr
 City, State ZIP Code: Colby KS 67701

GPS unit (Make/Model): Garmin ETrex 10
 Digital Map/Photo, Topographic Map, Land Survey
 Est. Accuracy: < 3 m, 3-5 m, 5-15 m, > 15 m

3 **MARK WELL'S LOCATION WITH AN "X" IN SECTION BOX:**

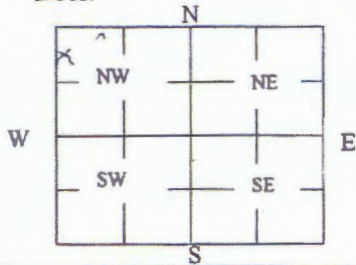

4 **DEPTH OF WELL** 122 ft.
WELL'S STATIC WATER LEVEL 108 ft.

WELL WAS USED AS:

- Domestic Public Water Supply Dewatering
 Irrigation Oil Field Water Supply Monitoring
 Feedlot Domestic (Lawn & Garden) Injection Well
 Industrial Air Conditioning Other _____

Was a chemical/bacteriological sample submitted to Department? Yes No

5 **TYPE OF BLANK CASING USED:**

- Steel RMP (SR) Wrought Fiberglass Other (Specify below)
 PVC ABS Asbestos-Cement Concrete Tile

Blank casing diameter 5' in. Was casing pulled? Yes No If yes, how much _____
 Casing height above or below land surface 54 in. (at floor)

6 **GROUT PLUG MATERIAL:** Neat cement Cement grout Bentonite Other _____

Grout Plug Intervals: From 90 ft. to 10 ft., From 10 ft. to 7 ft., From _____ ft. to _____ ft.

What is the nearest source of possible contamination:

- Septic tank Seepage pit Fuel storage Other (specify below)
 Sewer lines Pit privy Fertilizer storage
 Watertight sewer lines Sewage lagoon Insecticide storage
 Lateral lines Feedyard Abandoned water well Oil well/Gas well
 Cess pool Livestock pens Direction from well? N-NW
 How many feet? 150'

FROM	TO	PLUGGING MATERIALS	FROM	TO	PLUGGING MATERIALS
122	90	Washed Sand			
90	10	Bentonite			
10	7	Cement Grout			
7	15	Well Pit Floor			

7 **CONTRACTOR'S OR LANDOWNER'S CERTIFICATION:** This water well was plugged under my jurisdiction and was completed on (mo/day/year) 7-31-17 and this record is true to the best of my knowledge and belief. Kansas Water Well Contractor's License No. 643. This Water Well Record was completed on (mo/day/year) 8-7-17 under the business name of Bronn Pump & Supply by (signature) _____

Send one white copy to Kansas Department of Health & Environment, Geology Section, 1000 SW Jackson Street, Ste. 420, Topeka, KS 66612-1367. Send one copy to WATER WELL OWNER and retain one for your records.
 Visit us at <http://www.kdheks.gov/waterwell/index.html> Telephone 785-296-5524.