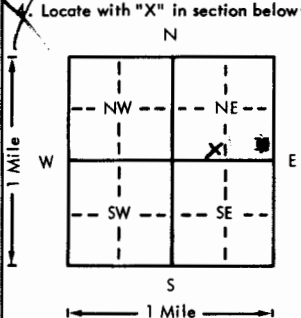


USE TYPEWRITER OR BALL
POINT PEN-PRESS FIRMLY,
PRINT CLEARLY.

WATER WELL RECORD
KSA 82a-1201-1215

Kansas Department of Health and
Environment-Division of Environment
(Water well Contractors)
Topeka, Kansas 66620

TWP: Morgan

1. Location of well:		County Thomas	Section SE 1/4 SW 1/4 NE 1/4	Section number 36	Township number T 7 S R 33	Range number 33
2. Distance and direction from nearest town or city: 6 Miles E; 3/4 mile N; 1/4 mile West to Well Street address of well location if in city:				3. Owner of well: Frank Flipse R.R. or street: City, state, zip code: Colby, Kansas		
4. Locate with "X" in section below: 				Sketch map:		
5. Type and color of material				From	To	
Clay				0	78'	
Coarse sand and gravel				78	98	
Cement				98	103	
Sandy Clay				103	112	
Clay				112	120	
Clay and sandy clay and cement				120	150	
Fine to coarse sand				150	159	
Sandstone				159	165	
Coarse sand and gravel and clay layers				165	176	
Sand and gravel and sandstone streaks				176	185	
Clay and cement				185	193	
Coarse sand and gravel				193	226	
Clay and streaks of sand and gravel				226	237	
Coarse sand and gravel				237	245	
Clay				245	248	
Coarse sand and gravel				248	255	
Clay				255	256	
Coarse sand and gravel				256	261	
Ochre and shale				261	265	
(Use a second sheet if needed)						
18. Elevation:		19. Remarks: BROCK 261		20. Water well contractor's certification: This well was drilled under my jurisdiction and this report is true to the best of my knowledge and belief. Western Well & PUMP, Inc. 245 Business name License No. Address P.O. Box 852 Colby, KANSAS Signed Sally Berry Date 8-10-76 Authorized representative		
Topography: Hill Slope <input checked="" type="checkbox"/> Upland Valley						

Forward the white, blue and pink copies to the Department of Health and Environment

Form WWC-5