

1 LOCATION OF WATER WELL:	Fraction	Section Number	Township Number	Range Number
County: Thomas	NW 1/4 SW 1/4 SE 1/4	31	T 7 S	R 33 EW

Distance and direction from nearest town or city street address of well if located within city?

2 WATER WELL OWNER: **Pyramid Oil**

RR#, St. Address, Box # :

City, State, ZIP Code : **Colby, Ks. 67701**

MW #12

Board of Agriculture, Division of Water Resources


Application Number:

3 LOCATE WELL'S LOCATION WITH AN "X" IN SECTION BOX:

4 DEPTH OF COMPLETED WELL

123

ft. ELEVATION:

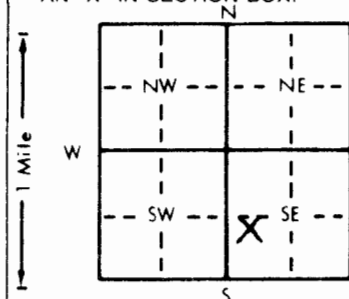

Depth(s) Groundwater Encountered 1 ft. 2 ft. 3 ft.

WELL'S STATIC WATER LEVEL **100.45** ft. below land surface measured on mo/day/yr

Pump test data: Well water was ft. after hours pumping gpm

Est. Yield gpm: Well water was ft. after hours pumping gpm

Bore Hole Diameter **8** in. to **123** ft. and in. to ft.

WELL WATER TO BE USED AS: 5 Public water supply 8 Air conditioning 11 Injection well

1 Domestic 3 Feedlot 6 Oil field water supply 9 Dewatering 12 Other (Specify below)

2 Irrigation 4 Industrial 7 Lawn and garden only 10 Monitoring wellWas a chemical/bacteriological sample submitted to Department? Yes No **X**; If yes, mo/day/yr sample was submittedWater Well Disinfected? Yes No **X**

5 TYPE OF BLANK CASING USED:

5 Wrought iron

8 Concrete tile

CASING JOINTS: Glued Clamped

1 Steel 3 RMP (SR)

6 Asbestos-Cement

9 Other (specify below)

Welded

2 PVC 4 ABS

7 Fiberglass

Threaded **X**Blank casing diameter **4** in. to **93** ft. Dia. in. to ft. Dia. in. to ft.Casing height above land surface **0** in., weight **2.071** lbs./ft. Wall thickness or gauge No. **.237**

TYPE OF SCREEN OR PERFORATION MATERIAL:

1 Steel 3 Stainless steel

5 Fiberglass

8 RMP (SR)

10 Asbestos-cement

2 Brass 4 Galvanized steel

6 Concrete tile

9 ABS

11 Other (specify)

12 None used (open hole)

SCREEN OR PERFORATION OPENINGS ARE:

1 Continuous slot

3 Mill slot

5 Gauzed wrapped

8 Saw cut

11 None (open hole)

2 Louvered shutter

4 Key punched

6 Wire wrapped

9 Drilled holes

7 Torch cut

10 Other (specify)

SCREEN-PERFORATED INTERVALS: From **93** ft. to **123** ft. From ft. to ft.

From ft. to ft. From ft. to ft.

GRAVEL PACK INTERVALS: From **90** ft. to **123** ft. From ft. to ft.

From ft. to ft. From ft. to ft.

6 GROUT MATERIAL:

1 Neat cement

2 Cement grout

3 Bentonite

4 Other

Grout intervals: From **0** ft. to **87** ft. From **87** ft. to **90** ft. From ft. to ft.

What is the nearest source of possible contamination:

1 Septic tank

4 Lateral lines

7 Pit privy

10 Livestock pens

14 Abandoned water well

2 Sewer lines

5 Cess pool

8 Sewage lagoon

11 Fuel storage

15 Oil well/Gas well

3 Watertight sewer lines

6 Seepage pit

9 Feedyard

12 Fertilizer storage

16 Other (specify below)

13 Insecticide storage

Removed Fuel Storage

Direction from well?

How many feet?

FROM	TO	LITHOLOGIC LOG	FROM	TO	PLUGGING INTERVALS
0	.6	Cement	107	115	Fine to Med. Sand w/Clay
.6	20	Loess	115	120	Fine to Med. Sand
20	40	Clay w/Caliche & Some Sand	120	123	Cemented Sand & Caliche w/Sand Strks.
40	42	Med. Sand w/Clay & Rocks			
42	57	Sandy Clay w/Caliche & a little fine sand			
57	67	Fine to Med. Sand Gravel w/Rocks & Clay			
67	69	Hard Caliche			
69	74	Sandy Clay w/Caliche			
74	80	Sandy Clay w/Caliche & Sand Strks.			
80	85	Med. Sand & Gravel w/a few Clay Strks.			
85	90	Sandy Clay & Caliche			
90	95	Caliche w/Clay Strks.			
95	107	Fine to Med. Sand & Gravel w/some Clay Strks.			

7 CONTRACTOR'S OR LANDOWNER'S CERTIFICATION: This water well was (1) constructed, (2) reconstructed, or (3) plugged under my jurisdiction and was completed on (mo/day/year) **7-20-94** and this record is true to the best of my knowledge and belief KansasWater Well Contractor's License No. **554**

This Water Well Record was completed on (mo/day/yr)

9-12-94under the business name of **Woofter Pump & Well, Inc.**

by (signature)

Gay B. Woofter