

1 LOCATION OF WATER WELL:		Fraction	Section Number	Township Number	Range Number
County:	Thomas	NE $\frac{1}{4}$ SE $\frac{1}{4}$ SW $\frac{1}{4}$	31	T 7 S	R 33 EW


2 WATER WELL OWNER: Pyramid Oil

City, State, ZIP Code : Colby, Ks. 67701

MW#7

3 LOCATE WELL'S LOCATION WITH
AN "X" IN SECTION BOX:

4 DEPTH OF COMPLETED WELL 125 ft. ELEVATION:

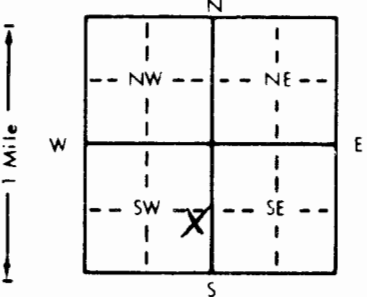

Depth(s) Groundwater Encountered 1. ft. 2. ft. 3. ft.

WELL'S STATIC WATER LEVEL 100.12 ft. below land surface measured on mo/day/yr

Pump test data: Well water was ft. after hours pumping gpm

Est. Yield gpm: Well water was ft. after hours pumping gpm

Bore Hole Diameter. . . . 8 . . . in. to 125 . . . ft., and in. to ft.

WELL WATER TO BE USED AS: 5 Public water supply 8 Air conditioning 11 Injection well

1 Domestic 3 Feedlot 6 Oil field water supply 9 Dewatering 12 Other (Specify below)

2 Irrigation 4 Industrial 7 Lawn and garden only 10 Monitoring well

Was a chemical/bacteriological sample submitted to Department? Yes.....No **X**.....; If yes, mo/day/yr sample was sub-

mitted _____ Water Well Disinfected? Yes _____ No ☒ X

5] TYPE OF BLANK CASING USED:

1 Steel	3 RMP (SR)
2 PVC	4 ABS

5 Wrought iron

8 Concrete tile

CASING JOINTS: Glued Clamped

Blank casing diameter 4 in. to 95 ft., Dia 0.25 in. to 0.25 ft., Dia 0.25 in. to 0.25 ft.

Casing height above land surface. 0 in., weight 2.071 lbs./ft. Wall thickness or gauge No.237

TYPE OF SCREEN OR PERFORATION MATERIAL:

1 Steel	3 Stainless steel	5 Fiberglass	8 RMP (SR)	11 Other (specify)
2 Brass	4 Galvanized steel	6 Concrete tile	9 ABS	12 None used (open hole)

SCREEN OR PERFORATION OPENINGS ARE:

1 Continuous slot	3 Mill slot	6 Wire wrapped	9 Drilled holes
2 Louvered shutter	4 Key punched	7 Torch cut	10 Other (specify)

SCREEN-PERFORATED INTERVALS: From 95 ft. to 125 ft., From _____ ft. to _____ ft.

GRAVEL PACK INTERVALS: From 90 ft to 125 ft From ft to ft

6] GROUT MATERIAL:

1 Neat cement

2 Cement grout

3 Bentonite

4 Other

Grout Intervals: From 0 ft. to 87 ft., From 87 ft. to 90 ft., From _____ ft. to _____ ft.

What is the nearest source of possible contamination:

1 Septic tank	4 Lateral lines	7 Pit privy	11 Fuel storage	15 Oil well/Gas well
2 Sewer lines	5 Cess pool	8 Sewage lagoon	12 Fertilizer storage	16 Other (specify below)
3 Watertight sewer lines	6 Seepage pit	9 Feedyard	13 Insecticide storage	Removed Fuel Storage

Direction from well?

How many feet?

FROM	TO	LITHOLOGIC LOG	FROM	TO	PLUGGING INTERVALS
0	.4	Brick			
.4	.8	Sand			
.8	.10	Cement			
.10	20	Loess			
20	42	Clay w/Some Caliche			
42	48	Med. Sand w/Clay Strks.			
48	59	Sandy Clay w/Some Sand			
59	68	MEd. Sand w/Clay Strks.			
68	75	Sandy Clay w/Caliche			
75	80	Sandy Clay w/Caliche Strks.			
80	87	Med. Sand w/Some Clay			
87	98.5	Sandy Clay & Caliche			
98.5	103	Med. Sand w/Some Clay			
103	111	Tight Med. Sandy Clay			
111	126	Med. Sand & Gravel w/a few Clay Strks.			

7. CONTRACTOR'S OR LANDOWNER'S CERTIFICATION: This water well was (1) constructed, (2) reconstructed, or (3) plugged under my jurisdiction and was completed on (mo/day/year) 7-14-94 and this record is true to the best of my knowledge and belief. Kansas

Water Well Contractor's License No.

This Water Well Record was completed on (mo/day/yr)

under the business name of **Woofter Pump & Well, Inc.**

by (signature) _____

INSTRUCTIONS: Use typewriter or ball point pen. PLEASE PRESS FIRMLY and PRINT clearly. Please fill in blanks, underline or circle the correct answers. Send top three copies to Kansas Department of Health and Environment, Bureau of Water, Topeka, Kansas 66620-0001. Telephone: 913-296-5545. Send one to WATER WELL OWNER and retain one for your records.