


LOCATION OF WATER WELL:		Fraction	Section Number	Township Number	Range Number
County: Thomas		NE ¼ SW ¼ SE ¼	31	T 7 S	R 33 E W

405 East 4th, Colby, Kansas

Application Number:

mitted Water Well Disinfected? Yes No ☒ X

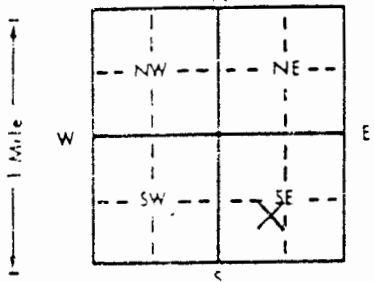

ent: (2) Cement grout (3) Bentonite 4 Other

20

FROM	TO	LITHOLOGIC LOG	FROM	TO	PLUGGING INTERVALS
0	6"	Concrete			
6"	3'	Dark brown clay			
3	43	Light brown clay			
43	47	Gray brown clay			
47	53	Red brownclay			
53	65	Very fine to fine sand			
65	75	Fine to coarse sand			
75	95	Very fine to fine sand			
95	100	Red brown sandy clay			
					VOBW2D
					Flushmount

by (signature)

INSTRUCTIONS Use typewriter or ball point pen. PLEASE PRESS FIRMLY and PRINT clearly. Please fill in blanks, underline or circle the correct answers. Send top three copies to Kansas Department of Health and Environment, Bureau of Water, Topeka, Kansas 66620-0001. Telephone: 913-296-5545. Send one to WATER WELL OWNER and retain one for your records.