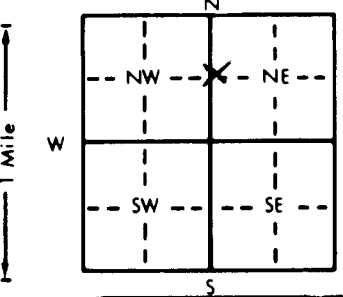
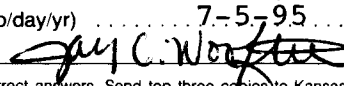


1 LOCATION OF WATER WELL:		Fraction	Section Number	Township Number	Range Number
County: Thomas		$\frac{1}{4}$ $\frac{1}{4}$ N $1\frac{1}{2}$ $\frac{1}{4}$	36	T 7 S	R 34 EW
Distance and direction from nearest town or city street address of well if located within city? Lots 22 & 23, Block 2 in El Chaparral North of Colby					
2 WATER WELL OWNER: Jody Smith					
RR#, St. Address, Box # : 1150 S. Franklin			Board of Agriculture, Division of Water Resources		
City, State, ZIP Code : Lot 83, Colby, Ks. 67701			Application Number:		
3 LOCATE WELL'S LOCATION WITH AN "X" IN SECTION BOX:		4 DEPTH OF COMPLETED WELL: 195 ft. ELEVATION:			
		Depth(s) Groundwater Encountered 1. ft. 2. ft. 3. ft. WELL'S STATIC WATER LEVEL 99 ft. below land surface measured on mo/day/yr Pump test data: Well water was ft. after hours pumping gpm Est. Yield gpm: Well water was ft. after hours pumping gpm Bore Hole Diameter .8 in. to 1.95 ft., and in. to ft. WELL WATER TO BE USED AS: 5 Public water supply 8 Air conditioning 11 Injection well 1 Domestic 3 Feedlot 6 Oil field water supply 9 Dewatering 12 Other (Specify below) 2 Irrigation 4 Industrial 7 Lawn and garden only 10 Monitoring well Was a chemical/bacteriological sample submitted to Department? Yes.....No... X; If yes, mo/day/yr sample was submitted Water Well Disinfected? Yes No X			
5 TYPE OF BLANK CASING USED:					
1 Steel		3 RMP (SR)	5 Wrought iron	8 Concrete tile	CASING JOINTS: Glued X Clamped
2 PVC		4 ABS	6 Asbestos-Cement	9 Other (specify below)	Welded
			7 Fiberglass		Threaded
Blank casing diameter 4.5 in. to 155 ft., Dia. in. to ft., Dia. in. to ft.					
Casing height above land surface 18 in., weight 2.38 lbs./ft. Wall thickness or gauge No. 248					
TYPE OF SCREEN OR PERFORATION MATERIAL:					
1 Steel		3 Stainless steel	5 Fiberglass	8 RMP (SR)	11 Other (specify)
2 Brass		4 Galvanized steel	6 Concrete tile	9 ABS	12 None used (open hole)
SCREEN OR PERFORATION OPENINGS ARE:					
1 Continuous slot		3 Mill slot	5 Gauzed wrapped	8 Saw cut	11 None (open hole)
2 Louvered shutter		4 Key punched	6 Wire wrapped	9 Drilled holes	
			7 Torch cut	10 Other (specify)	
SCREEN-PERFORATED INTERVALS: From 155 ft. to 195 ft., From ft. to ft.					
From ft. to ft., From ft. to ft.					
GRAVEL PACK INTERVALS: From 20 ft. to 195 ft., From ft. to ft.					
From ft. to ft., From ft. to ft.					
6 GROUT MATERIAL: 1 Neat cement 2 Cement grout 3 Bentonite 4 Other					
Grout Intervals: From 0 ft. to 20 ft., From ft. to ft., From ft. to ft.					
What is the nearest source of possible contamination: NONE					
1 Septic tank		4 Lateral lines	7 Pit privy	10 Livestock pens	14 Abandoned water well
2 Sewer lines		5 Cess pool	8 Sewage lagoon	11 Fuel storage	15 Oil well/Gas well
3 Watertight sewer lines		6 Seepage pit	9 Feedyard	12 Fertilizer storage	16 Other (specify below)
				13 Insecticide storage	
Direction from well? How many feet?					
FROM	TO	LITHOLOGIC LOG	FROM	TO	PLUGGING INTERVALS
0	2	Surface	167	171	Cemented Sand w/Sand Strks.
2	20	Loess	171	172.5	Med. Sand & Gravel
20	52	Clay & Caliche	172.5	176	Tight Med.Sand & Gravel
52	66	Med. Sand w/Clay Str.&Gravel	176	180	Med. Sand & Gravel
66	76	Cemented Sand w/Clay Strks.	180	195	Ochre & Shale
76	87	Med. Sand & Clay Strks.			
87	92	Sandy Clay & Caliche w/S.Sand			
92	99	Med. Sand & Gravel			
99	100	Caliche			
100	112	Tight Med. Sand w/Clay Strks.			
112	123	Med.Sand & Gravel			
123	132	Sandy Clay w/Sand Strks.			
132	143	Med. Sand w/Clay Strks.			
143	151	Cemented w/Clay & Sand Strks.			
151	167	Med.Sand & Gravel			
7 CONTRACTOR'S OR LANDOWNER'S CERTIFICATION: This water well was (1) constructed, (2) reconstructed, or (3) plugged under my jurisdiction and was completed on (mo/day/year) 7-5-95 and this record is true to the best of my knowledge and belief. Kansas Water Well Contractor's License No. 554 This Water Well Record was completed on (mo/day/yr) 7-5-95 under the business name of Woofter Pump & Well, Inc. by (signature) 					
INSTRUCTIONS: Use typewriter or ball point pen. PLEASE PRESS FIRMLY and PRINT clearly. Please fill in blanks, underline or circle the correct answers. Send top three copies to Kansas Department of Health and Environment, Bureau of Water, Topeka, Kansas 66620-0001. Telephone: 913-296-5545. Send one to WATER WELL OWNER and retain one for your records.					