

CORRECTION(S) TO WATER WELL RECORD (Form WWC-5)

(to rectify lacking or incorrect information)

LOCATION OF WATER WELL: County: <u>Thomas</u>	Fraction <u>SW</u> $\frac{1}{4}$ <u>SW</u> $\frac{1}{4}$ <u>SE</u> $\frac{1}{4}$ <u>SE</u> $\frac{1}{4}$	Section <u>36</u>	Township T <u>7</u> S	Range R <u>34</u> ☐ E ☒ W
---	---	----------------------	--------------------------	---

Owner: City of Colby

Location was listed as:
Sec. 36 T 7 S R 34 ☐ E ☒ W
Fraction: SW SW SE

Location changed to:
Sec. 36 T 7 S R 34 ☐ E ☒ W
Fraction: SW SW SE SE

Other changes: Initial statements: _____

Changed to: _____

Comments: Constructed record of SVE 5 ID

Verification method: Interactive Map and correspondents with MILCO Environmental Services, Inc.

_____ initials: DRL date: 11-17-2016
Submitted by: Kansas Geological Survey, Data Resources Library, 1930 Constant Ave., Lawrence, KS 66047-3726
to: Kansas Dept of Health & Environment, Bureau of Water, 1000 SW Jackson, Suite 420, Topeka, KS 66612-1367.

1) LOCATION OF WATER WELL:	Fraction	Section Number	Township Number	Range Number
County: Thomas	SW ¼ SW ¼ SE ¼	36	T 7 S	R 34 E/W

Distance and direction from nearest town or city street address of well if located within city?

Colby Public Power, Kansas

2 WATER WELL OWNER:		
RR#, St. Address, Box #	City of Colby 585N. Franklin	Board of Agriculture, Division of Water Resources
City, State, ZIP Code	Colby, Kansas 67701	Application Number:

3 LOCATE WELL'S LOCATION WITH AN "X" IN SECTION BOX:

1 Mile

N

W E

NW NE

SW SE

X

4 DEPTH OF COMPLETED WELL 100 ft ELEVATION: 999

Depth(s) Groundwater Encountered 1. ft 2. ft 3. ft

WELL'S STATIC WATER LEVEL ft. below land surface measured on mo/day/yr

Pump test data: Well water was NA ft after hours pumping gpm

Est. Yield NA gpm: Well water was ft after hours pumping gpm

Bore Hole Diameter 8 in. to 112 ft, and in. to ft

WELL WATER TO BE USED AS:

5 Public water supply	8 Air conditioning	11 Injection well
1 Domestic	3 Feedlot	6 Oil field water supply
2 Irrigation	4 Industrial	7 Lawn and garden only
		10 Monitoring well
		12 Other (Specify below)

Was a chemical/bacteriological sample submitted to Department? Yes.....No.....✓ If yes, mo/day/yr sample was submitted

Water Well Disinfected? Yes No ✓

5 TYPE OF BLANK CASING USED:		5 Wrought iron	8 Concrete tile	CASING JOINTS: Glued Clamped	
1 Steel	3 RMP (SR)	6 Asbestos-Cement	9 Other (specify below)	Welded	
2 PVC	4 ABS	7 Fiberglass		Threaded. ☒	
Blank casing diameter 2 in. to 80 ft. Dia 2 in. to 40 ft. Dia in. to ft.					
Casing height above land surface 0 in. weight Sch 40 lbs./ft.		Wall thickness or gauge No.			
TYPE OF SCREEN OR PERFORATION MATERIAL		7 PVC	10 Asbestos-cement		
1 Steel	3 Stainless steel	5 Fiberglass	8 RMP (SR)	11 Other (specify)	
2 Brass	4 Galvanized steel	6 Concrete tile	9 ABS	12 None used (open hole)	
SCREEN OR PERFORATION OPENINGS ARE:		5 Gauzed wrapped	8 Saw cut	11 None (open hole)	
1 Continuous slot	3 Mill slot	6 Wire wrapped	9 Drilled holes		
2 Louvered shutter	4 Key punched	7 Torch cut	10 Other (specify)		
SCREEN-PERFORATED INTERVALS:		From 80 ft. to 100 ft.	From 40 ft. to 70 ft.		
		From ft. to ft.	From ft. to ft.		
GRAVEL PACK INTERVALS:		From 78 ft. to 100 ft.	From 38 ft. to 70 ft.		
		From ft. to ft.	From ft. to ft.		

6 GROUT MATERIAL: 1 Neat cement 2 Cement grout 3 Bentonite 4 Other

Grout Intervals: From 0 ft. to 70 ft., From 70 ft. to 78 ft., From ft. to ft.

What is the nearest source of possible contamination:

1 Septic tank	4 Lateral lines	7 Pit privy	10 Livestock pens	14 Abandoned water well
2 Sewer lines	5 Cess pool	8 Sewage lagoon	11 Fuel storage	15 Oil well/Gas well
3 Watertight sewer lines	6 Seepage pit	9 Feedyard	12 Fertilizer storage	16 Other (specify below)
			13 Insecticide storage	Former Tank Basin


Direction from well? North

How many feet? 150

[illegible]

7 CONTRACTOR'S OR LANDOWNER'S CERTIFICATION: This water well was (1) constructed, (2) reconstructed, or (3) plugged under my jurisdiction and was completed on (mo/day/year) 12/10/98 and this record is true to the best of my knowledge and belief.
Kansas Water Well Contractor's License No. 527 This Water Well Record was completed on (mo/day/yr) 1/14/99
under the business name of GeoCore Services, Inc. by (signature) [Signature]

INSTRUCTIONS: Use typewriter or ball point pen. **PLEASE PRESS FIRMLY** and **PRINT** clearly. Please fill in blanks, underline or circle the correct answers. Send top three copies to Kansas Department of Health and Environment, Bureau of Water, Topeka, Kansas 66620-0001. Telephone: 913-296-5545. Send one to WATER WELL OWNER and retain one for your records.

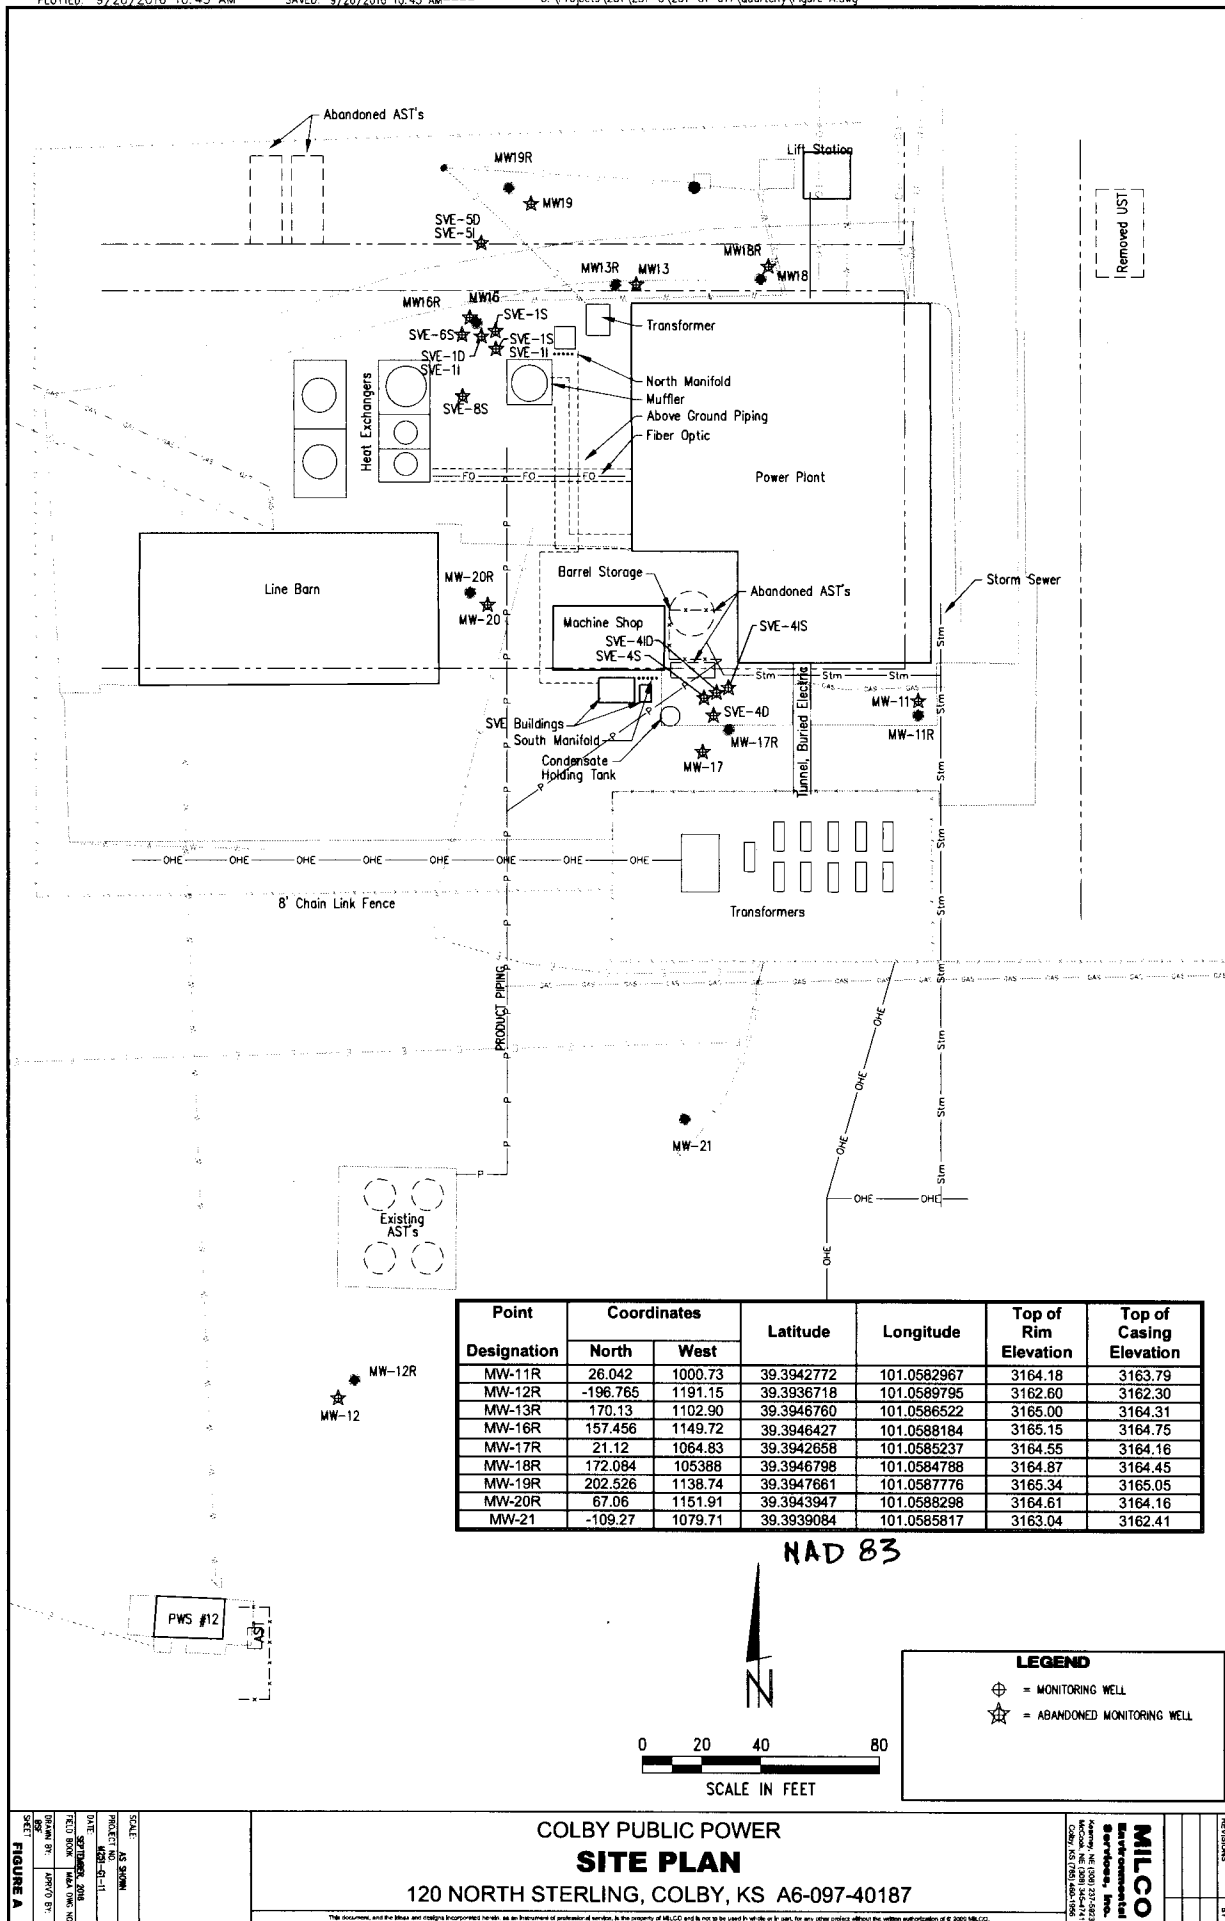

(per surveyor via driller)