

CORRECTION(S) TO WATER WELL RECORD (Form WWC-5)

(to rectify lacking or incorrect information)

LOCATION OF WATER WELL: County: <u>Thomas</u>	Fraction <u>SW</u> $\frac{1}{4}$ <u>SW</u> $\frac{1}{4}$ <u>SE</u> $\frac{1}{4}$ <u>SE</u> $\frac{1}{4}$	Section <u>36</u>	Township T <u>7</u> S	Range R <u>34</u> ☐ E ☒ W
---	---	----------------------	--------------------------	---

Owner: City of Colby

Location was listed as:
Sec. 36 T 7 S R 34 ☐ E ☒ W
Fraction: SW SW SE

Location changed to:
Sec. 36 T 7 S R 34 ☐ E ☒ W
Fraction: SW SW SE SE

Other changes: Initial statements: _____


Changed to: _____

Comments: Constructed record of SVE 1 IS

Verification method: Interactive Map and correspondents with MILCO Environmental Services, Inc.

_____ initials: DRL date: 11-17-2016
Submitted by: Kansas Geological Survey, Data Resources Library, 1930 Constant Ave., Lawrence, KS 66047-3726
to: Kansas Dept of Health & Environment, Bureau of Water, 1000 SW Jackson, Suite 420, Topeka, KS 66612-1367.

INSTRUCTIONS: Use typewriter or ball point pen. **PLEASE PRESS FIRMLY** and **PRINT** clearly. Please fill in blanks, underline or circle the correct answers. Send top three copies to Kansas Department of Health and Environment, Bureau of Water, Topeka, Kansas 66620-0001. Telephone: 913-296-5545. Send one to **WATER WELL OWNER** and retain one for your records.

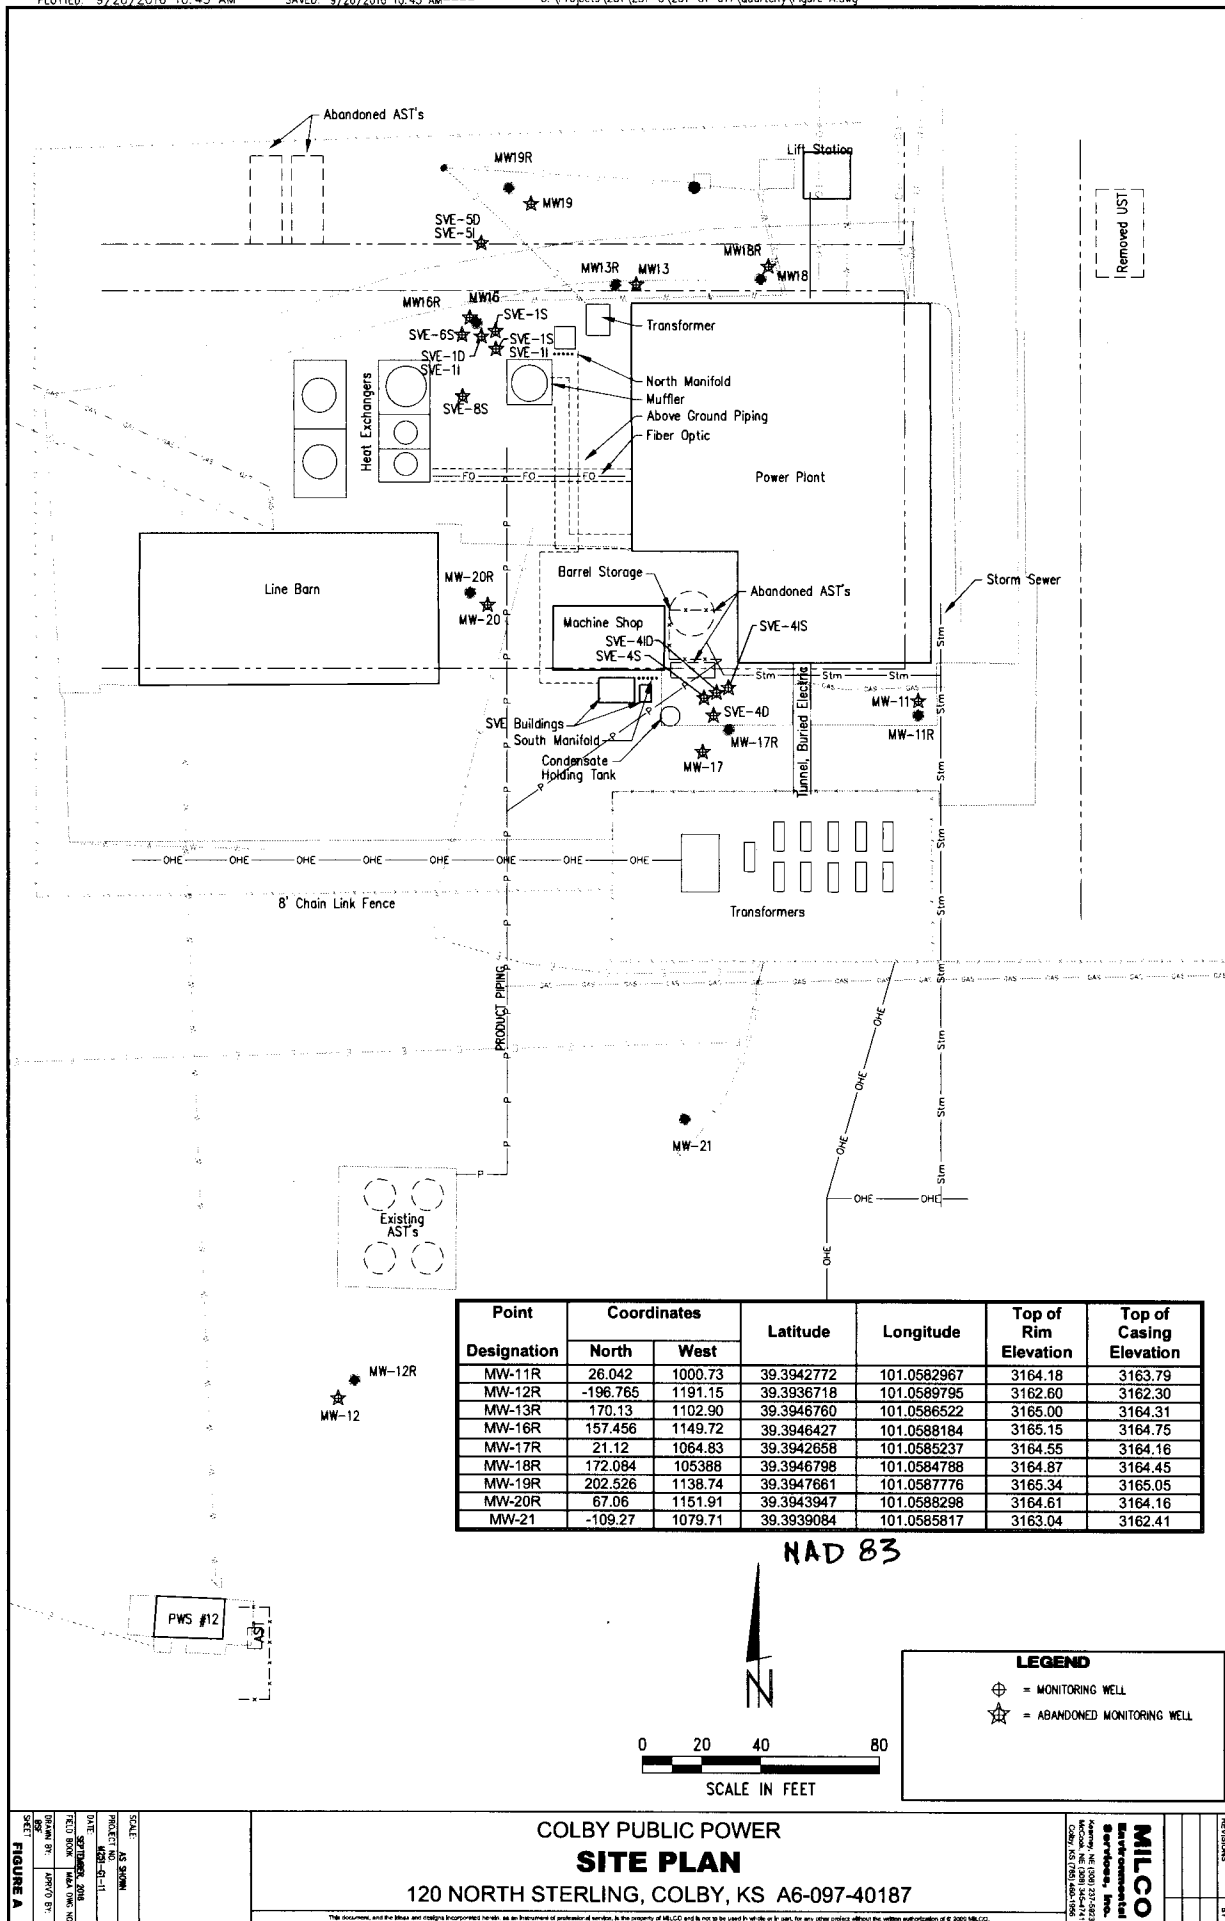

(per surveyor via driller)