

CORRECTION(S) TO WATER WELL RECORD (Form WWC-5)

(to rectify lacking or incorrect information)

LOCATION OF WATER WELL: County: <u>Thomas</u>	Fraction <u>SW</u> $\frac{1}{4}$ <u>SW</u> $\frac{1}{4}$ <u>SE</u> $\frac{1}{4}$ <u>SE</u> $\frac{1}{4}$	Section <u>36</u>	Township T <u>7</u> S	Range R <u>34</u> ☐ E ☒ W
---	---	----------------------	--------------------------	---

Owner: City of Colby

Location was listed as:
Sec. 36 T 7 S R 34 ☐ E ☒ W
Fraction: SW SW SE

Location changed to:
Sec. 36 T 7 S R 34 ☐ E ☒ W
Fraction: SW SW SE SE

Other changes: Initial statements: _____


Changed to: _____

Comments: Constructed record of SVE 1 ID

Verification method: Interactive Map and correspondents with MILCO Environmental Services, Inc.

initials: DRL date: 11-17-2016
Submitted by: Kansas Geological Survey, Data Resources Library, 1930 Constant Ave., Lawrence, KS 66047-3726
to: Kansas Dept of Health & Environment, Bureau of Water, 1000 SW Jackson, Suite 420, Topeka, KS 66612-1367.

1 LOCATION OF WATER WELL:		Fraction		Section Number		Township Number		Range Number	
County: Thomas		SW ¼ SW ¼ SE ¼		36		T 7 S		R 34 E/W	
Distance and direction from nearest town or city street address of well if located within city? Colby Public Power, Colby, Kansas									
2 WATER WELL OWNER: City of Colby RR#, St. Address, Box # : 585N. Franklin City, State, ZIP Code : Colby, Kansas 67701 Board of Agriculture, Division of Water Resources Application Number:									
3 LOCATE WELL'S LOCATION WITH AN "X" IN SECTION BOX:			4 DEPTH OF COMPLETED WELL 101 ft. ELEVATION: 999						
N 1 Mile W E S X			Depth(s) Groundwater Encountered 1. ft. 2. ft. 3. ft.						
			WELL'S STATIC WATER LEVEL ft. below land surface measured on mo/day/yr						
			Pump test data: Well water was NA ft. after hours pumping gpm						
			Est. Yield .. NA .. gpm: Well water was ft. after hours pumping gpm						
			Bore Hole Diameter 12 in. to 11.7 ft., and in. to ft.						
TYPE OF BLANK CASING USED:			5 Wrought iron 8 Concrete tile CASING JOINTS: Glued Clamped						
1 Steel 3 RMP (SR) 6 Asbestos-Cement 9 Other (specify below) Welded									
2 PVC 4 ABS 7 Fiberglass Threaded. ✓									
Blank casing diameter 4 in. to 76 ft. Dia in. to ft. Dia in. to ft.									
Casing height above land surface 0 in., weight Sch 40 lbs./ft. Wall thickness or gauge No.									
TYPE OF SCREEN OR PERFORATION MATERIAL			7 PVC 10 Asbestos-cement						
1 Steel 3 Stainless steel 5 Fiberglass 8 RMP (SR) 11 Other (specify)									
2 Brass 4 Galvanized steel 6 Concrete tile 9 ABS 12 None used (open hole)									
SCREEN OR PERFORATION OPENINGS ARE:			5 Gauzed wrapped 8 Saw cut 11 None (open hole)						
1 Continuous slot 3 Mill slot 6 Wire wrapped 9 Drilled holes									
2 Louvered shutter 4 Key punched 7 Torch cut 10 Other (specify)									
SCREEN-PERFORATED INTERVALS: From 76 ft. to 101 ft. From ft. to ft.									
GRAVEL PACK INTERVALS: From 73 ft. to 101 ft. From ft. to ft.									
From ft. to ft. From ft. to ft.									
6 GROUT MATERIAL: 1 Neat cement 2 Cement grout 3 Bentonite 4 Other									
Grout intervals: From 0 ft. to 69 ft. From 69 ft. to 73 ft. From ft. to ft.									
What is the nearest source of possible contamination:									
1 Septic tank 4 Lateral lines 7 Pit privy 10 Livestock pens 14 Abandoned water well									
2 Sewer lines 5 Cess pool 8 Sewage lagoon 11 Fuel storage 15 Oil well/Gas well									
3 Watertight sewer lines 6 Seepage pit 9 Feedyard 12 Fertilizer storage 16 Other (specify below)									
13 Insecticide storage Former Tank Basin									
How many feet? 125									
Direction from well? Southeast									
LITHOLOGIC LOG									
FROM	TO	LITHOLOGIC LOG		FROM	TO	PLUGGING INTERVALS			
0	4	Clay, Brown							
4	7	Clay, Brown							
7	31	Silt, Brown							
31	38	Clay, Red Brown							
38	48	Sand, Red Brown							
48	69	Sand, Brown-Red Brown							
69	73	Silt, Gray Green							
73	81	Clay, Green Gray							
81	94	Sand, Red Brown							
94	108	Sand, Red Brown							
108	117	Sand, Brown							
						SVEIID, Tag #, Flushmount			
						Project Name: Colby Public Power			
						GeoCore # 740, KDHE # A6 097 40187			
7 CONTRACTOR'S OR LANDOWNER'S CERTIFICATION: This water well was (1) constructed, (2) reconstructed, or (3) plugged under my jurisdiction and was completed on (mo/day/year) 11/30/98 and this record is true to the best of my knowledge and belief.									
Kansas Water Well Contractor's License No. 527 This Water Well Record was completed on (mo/day/yr) 1/14/99									
under the business name of GeoCore Services, Inc. by (signature) <i>Don Hall</i>									

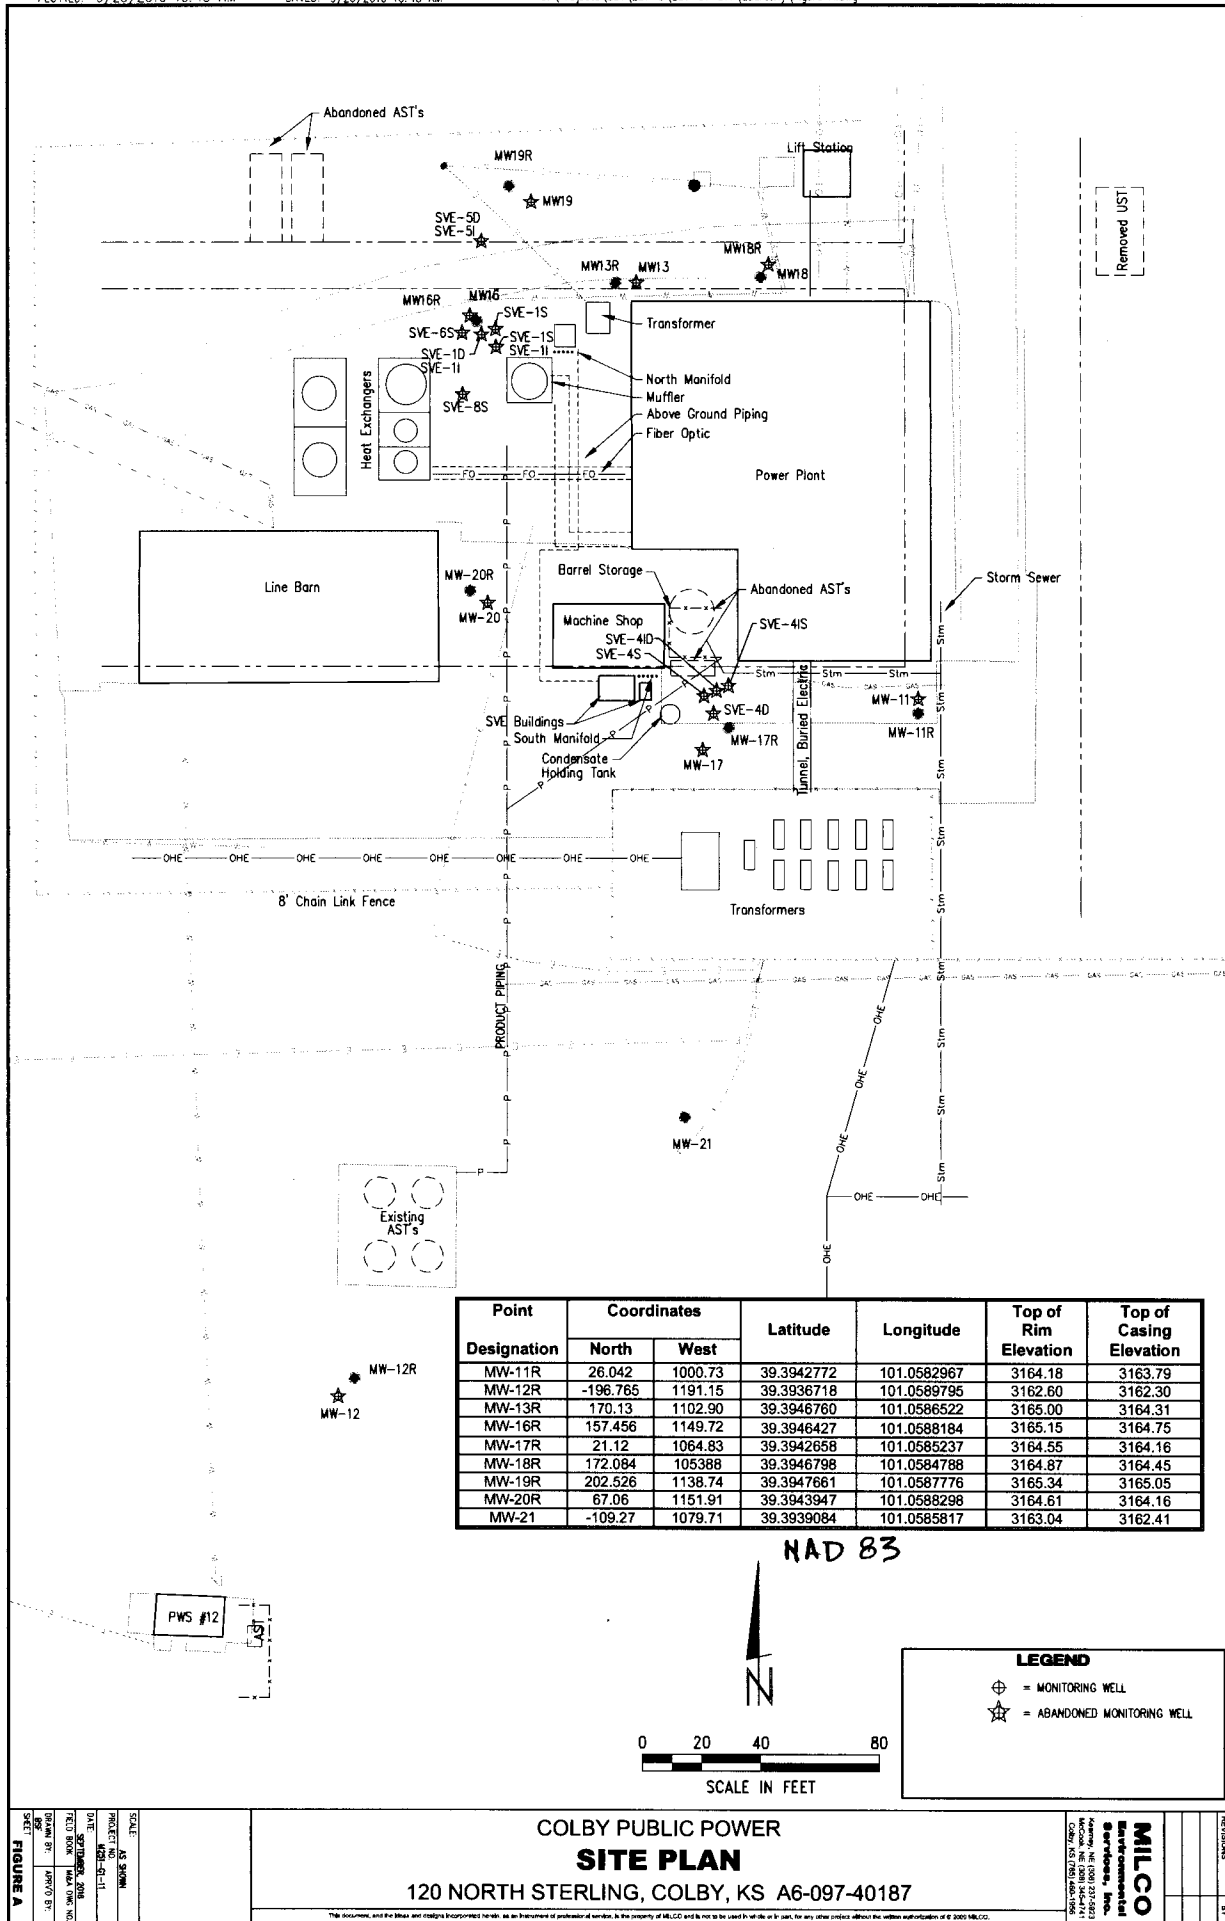

(per surveyor via driller)