

CORRECTION(S) TO WATER WELL RECORD (Form WWC-5)

(to rectify lacking or incorrect information)

LOCATION OF WATER WELL: County: <u>Thomas</u>	Fraction <u>SW</u> $\frac{1}{4}$ <u>SW</u> $\frac{1}{4}$ <u>SE</u> $\frac{1}{4}$ <u>SE</u> $\frac{1}{4}$	Section <u>36</u>	Township T <u>7</u> S	Range R <u>34</u> ☐ E ☒ W
---	---	----------------------	--------------------------	---

Owner: City of Colby

Location was listed as:
Sec. 36 T 7 S R 34 ☐ E ☒ W
Fraction: SW SW SE

Location changed to:
Sec. 36 T 7 S R 34 ☐ E ☒ W
Fraction: SW SW SE SE

Other changes: Initial statements: _____


Changed to: _____

Comments: Constructed record of MW 17

Verification method: Interactive Map and correspondents with MILCO Environmental Services, Inc.

initials: DRL date: 11-17-2016
Submitted by: Kansas Geological Survey, Data Resources Library, 1930 Constant Ave., Lawrence, KS 66047-3726
to: Kansas Dept of Health & Environment, Bureau of Water, 1000 SW Jackson, Suite 420, Topeka, KS 66612-1367.

INSTRUCTIONS: Use typewriter or ball point pen. PLEASE PRESS FIRMLY and PRINT clearly. Please fill in blanks, underline or circle the correct answers. Send top three copies to Kansas Department of Health and Environment, Bureau of Water, Topeka, Kansas 66620-0001. Telephone 785-296-5524. Send one to WATER WELL OWNER and retain one for your records. Fee of \$5.00 for each constructed well.

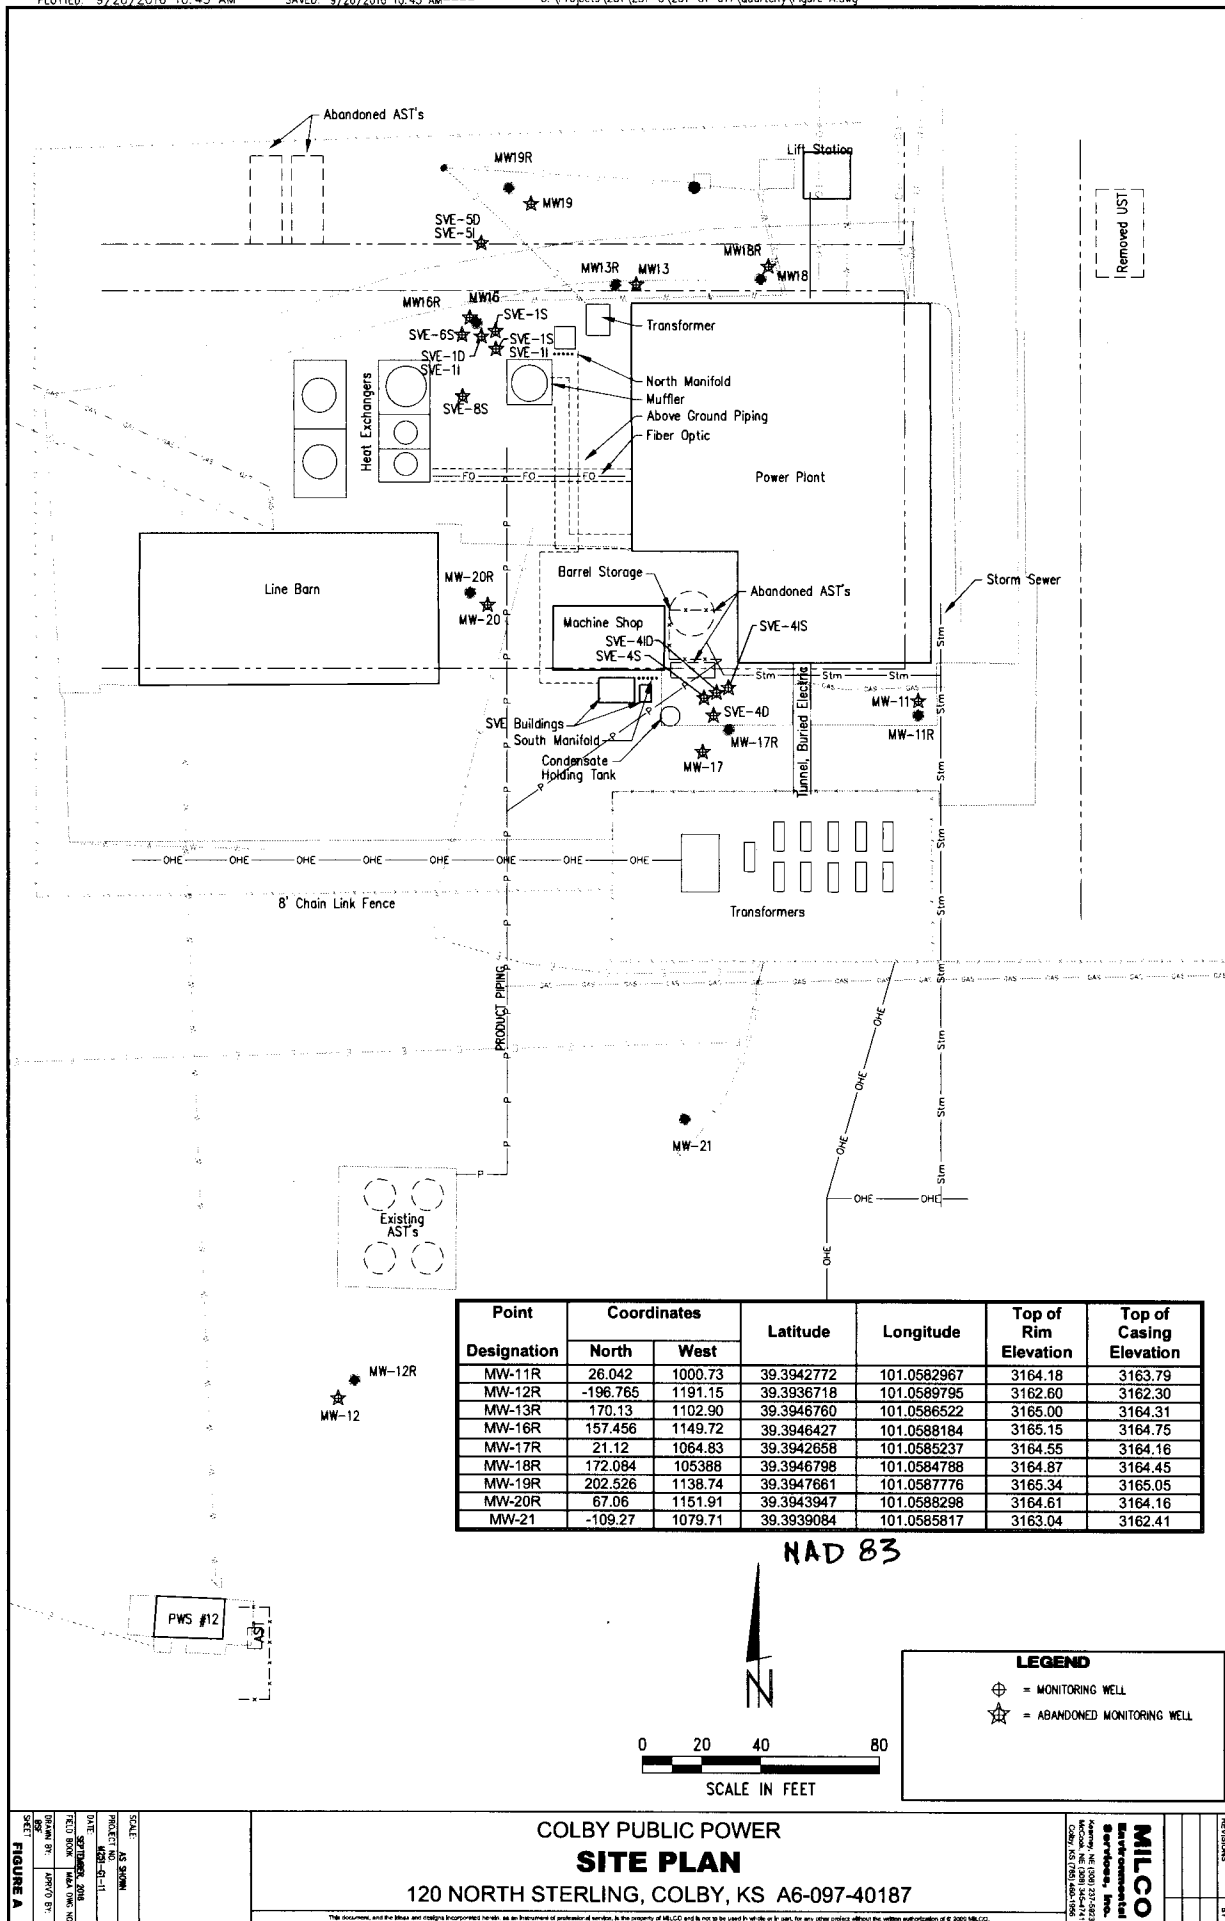

(per surveyor via driller)