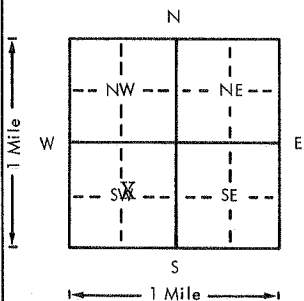


USE TYPEWRITER OR BALL
POINT PEN-PRESS FIRMLY,
PRINT CLEARLY.

WATER WELL RECORD
KSA 82a-1201-1215

Kansas Department of Health and
Environment-Division of Environment
(Water well Contractors)
Topeka, Kansas 66620

TWP: Rovoh1

1. Location of well:		County <u>Thomas</u>	Fraction <u>1/4 NE 1/4 SW 1/4</u>	Section number <u>4</u>	Township number <u>T 7 S</u>	Range number <u>R 34 W</u>
2. Distance and direction from nearest town or city: <u>From Hwy 24-25 junction 4mi. West 5 mi. North 1/4 mi.</u> Street address of well location if in city: <u>East 1/4 mi. North</u>				3. Owner of well: <u>Gary Cooper</u> R.R. or street: City, state, zip code: <u>Colby, Kansas</u>		
4. Locate with "X" in section below:		Sketch map:		6. Bore hole dia. <u>28</u> in. Completion date <u>2-28-76</u> Well depth <u>200</u> ft.		
				7. ☐ Cable tool ☐ Rotary ☐ Driven ☐ Dug ☐ Hollow rod ☐ Jetted ☐ Bored ☒ Reverse rotary		
				8. Use: ☒ Domestic ☐ Public supply ☐ Industry ☒ Irrigation ☐ Air conditioning ☐ Stock ☐ Lawn ☐ Oil field water ☐ Other		
5. Type and color of material		From	To	9. Casing: Material <u>Steel</u> Height: Above or below <u>XXX</u> Threaded ☐ Welded ☒ Surface <u>12</u> in. RMP ☐ PVC ☐ Weight <u> </u> lbs./ft. Dia. <u>16</u> in. to <u>70</u> ft. depth Wall Thickness: inches or Dia. <u> </u> in. to <u> </u> ft. depth gage No. <u>188</u>		
Clay		0	45	10. Screen: Manufacturer's name <u>Brown</u> <u>10" Cook</u> Type <u>Perforated</u> Dia. <u>16"</u> Slot/gauze <u>10%</u> Length <u> </u> Set between <u>130</u> ft. and <u>190</u> ft. <u>190</u> ft. and <u>200</u> ft. Gravel pack? ☒ Size range of material <u>1/4 X 5/8</u> 50%#1		
Sand & Gravel		45	55	11. Static water level: <u>85</u> ft. below land surface Date <u>3-6-76</u> mo./day/yr.		
Clay & sand & gravel		55	93	12. Pumping level below land surfaces: <u>672</u> <u>129</u> ft. after <u>2</u> hrs. pumping g.p.m. <u> </u> ft. after <u> </u> hrs. pumping g.p.m. Estimated maximum yield <u>672</u> g.p.m.		
sandy clay & cement		93	106	13. Water sample submitted: <u> </u> mo./day/yr. ☐ Yes ☒ No Date <u> </u>		
Clay		106	116	14. Well head completion: <u> </u> ☐ Pitless adapter <u>12</u> inches above grade		
Coarse sand & gravel		116	126	15. Well grouted? ☒ <u>Clay</u> With: ☐ Neat cement ☒ Bentonite ☒ Concrete ☒ Depth: From <u>0</u> ft. to <u>10</u> ft.		
Clay		126	131	16. Nearest source of possible contamination: <u> </u> ft. <u>5000</u> Direction <u>South</u> Type <u>Farm</u> Well disinfected upon completion? ☐ Yes ☒ No		
Medium coarse sand & gravel & clay		131	148	17. Pump: ☐ Not installed Manufacturer's name <u>Floway</u> Model number <u>7618</u> HP <u>100</u> Volts <u> </u> Length of drop pipe <u>190</u> ft. capacity <u>672</u> g.p.m. Type: <u>10 stage 10" DOH bowl</u> ☐ Submersible ☒ Turbine ☐ Jet ☐ Reciprocating ☐ Centrifugal ☐ Other		
Cement		148	151	20. Water well contractor's certification: This well was drilled under my jurisdiction and this report is true to the best of my knowledge and belief. <u>Western Well & Pump</u> <u>245</u> Business name License No. Address <u>PO Box 852 Colby, KS</u> Signed <u>Darryl Berry</u> Date <u>5/4/76</u> Authorized representative		
Coarse sand & gravel & cement		151	165			
Coarse sand & gravel white		165	173			
Clay		173	175			
Coarse sand & gravel white		175	183			
Coarse sand & gravel with clay		183	186			
Coarse sand & gravel white		186	208			
Ochre & shale		208	220			
(Use a second sheet if needed)						
18. Elevation:		19. Remarks: <u>BROCK 208'</u>				
Topography: ☐ Hill ☒ Slope ☐ Upland ☐ Valley						

Forward the white, blue and pink copies to the Department of Health and Environment

Form WWC-5