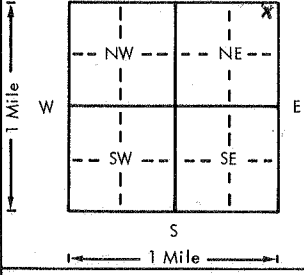


USE TYPEWRITER OR BALL
POINT PEN-PRESS FIRMLY,
PRINT CLEARLY.

WATER WELL RECORD
KSA 82a-1201-1215

Kansas Department of Health and
Environment-Division of Environment
(Water well Contractors)
Topeka, Kansas 66620

1. Location of well:		County Thomas	Fraction NE 1/4 NE 1/4 NE 1/4	Section number 12	Township number T 7 S R 34 E W	Range number
2. Distance and direction from nearest town or city: 4 1/2 North of Colby, KS 67701 Street address of well location if in city:				3. Owner of well: Vernon Barnett R.R. or street: RI City, state, zip code: Colby KS 67701		
4. Locate with "X" in section below:		Sketch map:		6. Bore hole dia. 8 3/8 in. Completion date 3-24-77 Well depth 230 ft.		
				7. ☐ Cable tool ☐ Rotary ☐ Driven ☐ Dug ☐ Hollow rod ☐ Jetted ☐ Bored ☒ Reverse rotary		
5. Type and color of material		From	To	8. Use: ☒ Domestic ☐ Public supply ☐ Industry ☐ Irrigation ☐ Air conditioning ☐ Stock ☐ Lawn ☐ Oil field water ☐ Other		
0-3 top soil				9. Casing: Material PVC Height: Above or below Threaded ☒ Welded ☐ Surface 12 in. RMP ☒ PVC ☒ Weight 12 lbs./ft. Dia. 5 in. to 230 ft. depth Wall Thickness: inches or Dia. 5 in. to 230 ft. depth gage No. 1/4		
3-90 Clay				10. Screen: Manufacturer's name Parsons Type P91 C Dia. 5 Slot/gauze 1/8 Length 40 Set between 190 ft. and 230 ft. Gravel pack? ☒ Size range of material 1/8 to 1/4		
90-105 Sandy Clay				11. Static water level: 168 ft. below land surface Date 6-20-77 mo./day/yr.		
105-130 Sand strip clay				12. Pumping level below land surfaces: ____ ft. after ____ hrs. pumping ____ g.p.m. ____ ft. after ____ hrs. pumping ____ g.p.m. Estimated maximum yield ____ g.p.m.		
130-138 Rock				13. Water sample submitted: ____ mo./day/yr. Yes ☒ No ☐ Date ____		
138-170 Clay strip of sand & gravel				14. Well head completion: ☒ Pitless adapter 18 inches above grade		
170-190 Pebbly Rock				15. Well grouted? ____ With: ____ Neat cement ____ Bentonite ☒ Concrete Depth: From 0 ft. to 12 ft.		
190-210 sand to med gravel				16. Nearest source of possible contamination: ft. 120 Direction South Type septic tank Well disinfected upon completion? ☒ Yes ____ No		
210-220 Clay strip of sand				17. Pump: Not installed Manufacturer's name Grundfos Model number 12 ED HP 1 Volts ____ Length of drop pipe 220 ft. capacity 7 g.p.m. Type: ☒ Submersible ____ Turbine ____ Jet ____ Reciprocating ____ Centrifugal ____ Other		
220-230 gravel				20. Water well contractor's certification: This well was drilled under my jurisdiction and this report is true to the best of my knowledge and belief. Jack Poore Drilling Co. 1977 Business name McDonald License No. KS 67745 Address KS 67745 Signed Jack Poore Date 8-11-77 Authorized representative		
18. Elevation:		19. Remarks: Domestic				
Topography: ☒ Hill ☐ Slope ☐ Upland ☐ Valley						

Forward the white, blue and pink copies to the Department of Health and Environment

Form WWC-5