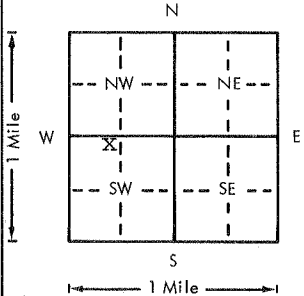


USE TYPEWRITER OR BALL
POINT PEN-PRESS FIRMLY,
PRINT CLEARLY.

WATER WELL RECORD
KSA 82a-1201-1215

Kansas Department of Health and
Environment-Division of Environment
(Water well Contractors)
Topeka, Kansas 66620

TWP: Morgan

1. Location of well:	County Thomas	Fraction NE 1/4 NW 1/4 SW 1/4	Section number 22	Township number T 7 S R 34	Range number X/W
2. Distance and direction from nearest town or city: From Colby, KS. Intersection U.S. 24 & K25; 3mi. W; 2 1/2 mi. N Street address of well location if in city: 1/4 Mile East			3. Owner of well: Craig and Doug Hills R.R. or street: City, state, zip code: Colby, Kansas		
4. Locate with "X" in section below: Sketch map: 			6. Bore hole dia. 30 in. Completion date 5/15/76 Well depth 218 ft.		
5. Type and color of material			7. <input type="checkbox"/> Cable tool <input type="checkbox"/> Rotary <input type="checkbox"/> Driven <input type="checkbox"/> Dug <input type="checkbox"/> Hollow rod <input type="checkbox"/> Jetted <input type="checkbox"/> Bored <input checked="" type="checkbox"/> Reverse rotary		
			8. Use: <input type="checkbox"/> Domestic <input type="checkbox"/> Public supply <input type="checkbox"/> Industry <input checked="" type="checkbox"/> Irrigation <input type="checkbox"/> Air conditioning <input type="checkbox"/> Stock <input type="checkbox"/> Lawn <input type="checkbox"/> Oil field water <input type="checkbox"/> Other		
			9. Casing: Material Steel Height: Above XXXX Threaded <input type="checkbox"/> Welded <input checked="" type="checkbox"/> Surface 12 in. RMP <input type="checkbox"/> PVC <input type="checkbox"/> Weight 188 lbs./ft. Dia: 16 in. to 128 ft. depth Wall Thickness: 1/8 inches or Dia. <input type="checkbox"/> in. to <input type="checkbox"/> ft. depth gage No. #7		
			10. Screen: Manufacturer's name Brown Type Regular Dia. 16 Slot/gauze 10% Length 80' Set between 128 ft. and 208 ft. 10' Cook 208 ft. and 218 ft. #1 Gravel pack? yes Size range of material 5/8 30%		
			11. Static water level: 120 ft. below land surface Date 5/15/76		
12. Pumping level below land surfaces: 210 ft. after 2 hrs. pumping 700 g.p.m. <input type="checkbox"/> ft. after <input type="checkbox"/> hrs. pumping <input type="checkbox"/> g.p.m. Estimated maximum yield 700 g.p.m.			13. Water sample submitted: XX mo./day/yr. Yes <input checked="" type="checkbox"/> No <input type="checkbox"/> Date		
14. Well head completion: <input type="checkbox"/> Pitless adapter 12 inches above grade			15. Well grouted? <input checked="" type="checkbox"/> Clay With: <input checked="" type="checkbox"/> Neat cement <input checked="" type="checkbox"/> Bentonite <input checked="" type="checkbox"/> Coke/Coke Depth: From 0 ft. to 10 ft.		
16. Nearest source of possible contamination: ft. 5000 Direction South Type Farm Well disinfected upon completion? <input type="checkbox"/> Yes <input checked="" type="checkbox"/> No			17. Pump: <input type="checkbox"/> Not installed Manufacturer's name Worthington Model number 22231 HP 90 Volts 240 Length of drop pipe 207 ft. capacity 550 g.p.m. Type: <input type="checkbox"/> Submersible <input checked="" type="checkbox"/> Turbine <input type="checkbox"/> Jet <input type="checkbox"/> Reciprocating <input type="checkbox"/> Centrifugal <input type="checkbox"/> Other		
18. Elevation:			20. Water well contractor's certification: This well was drilled under my jurisdiction and this report is true to the best of my knowledge and belief. Western Well & Pump, Inc. 245 Business name License No. Address P.O. Box 852 Colby, KS. Signed Sally Berry Date 8-10-76 Authorized representative		
19. Remarks: BROCK 215'					
Topography: <input type="checkbox"/> Hill <input type="checkbox"/> Slope <input checked="" type="checkbox"/> Upland <input type="checkbox"/> Valley					

Forward the white, blue and pink copies to the Department of Health and Environment

Form WWC-5