


1 LOCATION OF WATER WELL: County: Thomas Fraction: SE 1/4 NE 1/4 SE 1/4 Section Number: 36 Township Number: T 7 S Range Number: R 34 E

Distance and direction from nearest town or city street address of well if located within city?

1/4 M. N of Colby

2 WATER WELL OWNER: Vernie Hazlett  
 RR#, St. Address, Box #: Rt 3  
 City, State, ZIP Code: Colby, Kansas 67701  
 Board of Agriculture, Division of Water Resources  
 Application Number:

3 LOCATE WELL'S LOCATION WITH AN "X" IN SECTION BOX: SE DEPTH OF COMPLETED WELL: 222 ft. ELEVATION: \_\_\_\_\_

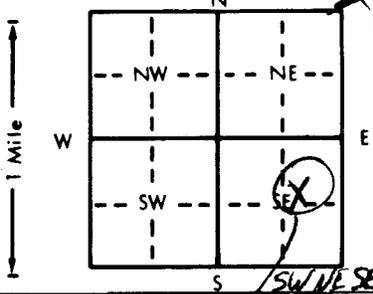

Depth(s) Groundwater Encountered 1. \_\_\_\_\_ ft. 2. \_\_\_\_\_ ft. 3. \_\_\_\_\_ ft.  
 WELL'S STATIC WATER LEVEL: 11.7 ft. below land surface measured on mo/day/yr 8/3/81  
 Pump test data: Well water was \_\_\_\_\_ ft. after \_\_\_\_\_ hours pumping \_\_\_\_\_ gpm  
 Est. Yield Not tested gpm: Well water was \_\_\_\_\_ ft. after \_\_\_\_\_ hours pumping \_\_\_\_\_ gpm  
 Bore Hole Diameter: 8 in. to 222 ft., and \_\_\_\_\_ in. to \_\_\_\_\_ ft.  
 WELL WATER TO BE USED AS:  Domestic  Feedlot  Oil field water supply  Dewatering  Other (Specify below)  
 Irrigation  Industrial  Lawn and garden only  Observation well  
 Was a chemical/bacteriological sample submitted to Department? Yes \_\_\_\_\_ No  If yes, mo/day/yr sample was sub-  
 mitted \_\_\_\_\_ Water Well Disinfected? Yes  No \_\_\_\_\_

5 TYPE OF BLANK CASING USED:  Steel  RMP (SR)  PVC  ABS  Wrought iron  Asbestos-Cement  Other (specify below)  Fiberglass  
 Blank casing diameter: 5 in. to 202 ft. Dia. \_\_\_\_\_ in. to \_\_\_\_\_ ft. Dia. \_\_\_\_\_ in. to \_\_\_\_\_ ft.  
 Casing height above land surface: 18 in., weight 18/10 lbs./ft. Wall thickness or gauge No. 14, 250

TYPE OF SCREEN OR PERFORATION MATERIAL:  Steel  Brass  Stainless steel  Galvanized steel  Fiberglass  Concrete tile  RMP (SR)  ABS  PVC  Asbestos-cement  Other (specify)  None used (open hole)

SCREEN OR PERFORATION OPENINGS ARE:  Continuous slot  Louvered shutter  Mill slot  Key punched  Gauzed wrapped  Wire wrapped  Torch cut  Saw cut  Drilled holes  None (open hole)

SCREEN-PERFORATED INTERVALS: From 5 ft. to 202 ft. From \_\_\_\_\_ ft. to \_\_\_\_\_ ft.  
 From 202 ft. to 222 ft. From \_\_\_\_\_ ft. to \_\_\_\_\_ ft.  
 GRAVEL PACK INTERVALS: From 18 ft. to 222 ft. From \_\_\_\_\_ ft. to \_\_\_\_\_ ft.  
 From \_\_\_\_\_ ft. to \_\_\_\_\_ ft. From \_\_\_\_\_ ft. to \_\_\_\_\_ ft.

6 GROUT MATERIAL:  Neat cement  Cement grout  Bentonite  Other  
 Grout Intervals: From 4 ft. to 18 ft. From \_\_\_\_\_ ft. to \_\_\_\_\_ ft. From \_\_\_\_\_ ft. to \_\_\_\_\_ ft.

What is the nearest source of possible contamination:  Septic tank  Sewer lines  Watertight sewer lines  Lateral lines  Cess pool  Seepage pit  Pit privy  Sewage lagoon  Feedyard  Livestock pens  Fuel storage  Fertilizer storage  Insecticide storage  Abandoned water well  Oil well/Gas well  Other (specify below)  
 Direction from well? West How many feet? 300

FROM	TO	LITHOLOGIC LOG	FROM	TO	LITHOLOGIC LOG
0	31	top soil			
31	39	sand			
39	76	sand & clay stripes			
76	91	sand rock			
91	109	sandy clay			
109	167	sand & sand rock stripes			
167	197	sand rock & sand strips Hard			
197	206	sand clay			
206	215	sand Good			
215	219	sand rock & sand stripes			
219	222	oker 6" shale			

7 CONTRACTOR'S OR LANDOWNER'S CERTIFICATION: This water well was  constructed, (2) reconstructed, or (3) plugged under my jurisdiction and was completed on (mo/day/year) 8/3/81 and this record is true to the best of my knowledge and belief. Kansas Water Well Contractor's License No. 139 This Water Well Record was completed on (mo/day/yr) 8/13/81 under the business name of Bartell Drilling by (signature) Dougline Bartell Strode

INSTRUCTIONS: Use typewriter or ball point pen, PLEASE PRESS FIRMLY and PRINT clearly. Please fill in blanks, underline or circle the correct answers. Send top three copies to Kansas Department of Health and Environment, Division of Environment, Environmental Geology Section, Topeka, KS 66620. Send one to WATER WELL OWNER and retain one for your records.

OFFICE USE ONLY  
T  
R  
34  
E  
36  
SW 1/4  
NE 1/4  
SE 1/4