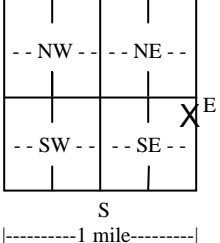


WATER WELL RECORD Form WWC-5 1252550

Division of Water
Resources App. No. Well ID Original Record Correction Change in Well Use

1 LOCATION OF WATER WELL: County:	Fraction $\frac{1}{4}$ $\frac{1}{4}$ $\frac{1}{4}$ $\frac{1}{4}$	Section Number	Township Number T S	Range Number R <input type="checkbox"/> E <input type="checkbox"/> W
---	---	----------------	---------------------------	---

2 WELL OWNER: Last Name: _____ First: _____ Business: _____ Address: _____ Address: _____ City: _____ State: _____ ZIP: _____	Street or Rural Address where well is located (if unknown, distance and direction from nearest town or intersection): If at owner's address, check here: <input type="checkbox"/>
--	---

3 LOCATE WELL WITH "X" IN SECTION BOX: N  S -----1 mile-----	4 DEPTH OF COMPLETED WELL: ft. Depth(s) Groundwater Encountered: 1) ft. 2) ft. 3) ft., or 4) <input type="checkbox"/> Dry Well WELL'S STATIC WATER LEVEL: ft. <input type="checkbox"/> below land surface, measured on (mo-day-yr)..... <input type="checkbox"/> above land surface, measured on (mo-day-yr)..... Pump test data: Well water was ft. after..... hours pumping gpm Well water was ft. after..... hours pumping gpm Estimated Yield:gpm Bore Hole Diameter: in. to ft. and in. to ft.	5 Latitude:(decimal degrees) Longitude:(decimal degrees) Datum: <input type="checkbox"/> WGS 84 <input type="checkbox"/> NAD 83 <input type="checkbox"/> NAD 27 <u>Source for Latitude/Longitude:</u> <input type="checkbox"/> GPS (unit make/model:) (WAAS enabled? <input type="checkbox"/> Yes <input type="checkbox"/> No) <input type="checkbox"/> Land Survey <input type="checkbox"/> Topographic Map <input type="checkbox"/> Online Mapper:
---	--	---

7 WELL WATER TO BE USED AS: 1. Domestic: 5. <input type="checkbox"/> Public Water Supply: well ID	10. <input type="checkbox"/> Oil Field Water Supply: lease
<input type="checkbox"/> Household 6. <input type="checkbox"/> Dewatering: how many wells?	11. Test Hole: well ID
<input type="checkbox"/> Lawn & Garden 7. <input type="checkbox"/> Aquifer Recharge: well ID	<input type="checkbox"/> Cased <input type="checkbox"/> Uncased <input type="checkbox"/> Geotechnical
<input type="checkbox"/> Livestock 8. <input type="checkbox"/> Monitoring: well ID	12. Geothermal: how many bores?
2. <input type="checkbox"/> Irrigation 9. Environmental Remediation: well ID	a) Closed Loop <input type="checkbox"/> Horizontal <input type="checkbox"/> Vertical
3. <input type="checkbox"/> Feedlot <input type="checkbox"/> Air Sparge <input type="checkbox"/> Soil Vapor Extraction	b) Open Loop <input type="checkbox"/> Surface Discharge <input type="checkbox"/> Inj. of Water
4. <input type="checkbox"/> Industrial <input type="checkbox"/> Recovery <input type="checkbox"/> Injection	13. <input type="checkbox"/> Other (specify):

Was a chemical/bacteriological sample submitted to KDHE? <input type="checkbox"/> Yes <input type="checkbox"/> No If yes, date sample was submitted:
Water well disinfected? <input type="checkbox"/> Yes <input type="checkbox"/> No

8 TYPE OF CASING USED: <input type="checkbox"/> Steel <input type="checkbox"/> PVC <input type="checkbox"/> Other	CASING JOINTS: <input type="checkbox"/> Glued <input type="checkbox"/> Clamped <input type="checkbox"/> Welded <input type="checkbox"/> Threaded
Casing diameter in. to ft., Diameter in. to ft., Diameter in. to ft.	Casing height above land surface in. Weight lbs./ft. Wall thickness or gauge No.

TYPE OF SCREEN OR PERFORATION MATERIAL:
 Steel Stainless Steel Fiberglass PVC Other (Specify)

Brass Galvanized Steel Concrete tile None used (open hole)

SCREEN OR PERFORATION OPENINGS ARE:
 Continuous Slot Mill Slot Gauze Wrapped Torch Cut Drilled Holes Other (Specify)

Louvered Shutter Key Punched Wire Wrapped Saw Cut None (Open Hole)

SCREEN-PERFORATED INTERVALS: From ft. to ft., From ft. to ft., From ft. to ft. ft.

GRAVEL PACK INTERVALS: From ft. to ft., From ft. to ft., From ft. to ft. ft.

9 GROUT MATERIAL: <input type="checkbox"/> Neat cement <input type="checkbox"/> Cement grout <input type="checkbox"/> Bentonite <input type="checkbox"/> Other
Grout Intervals: From ft. to ft., From ft. to ft., From ft. to ft. ft.

Nearest source of possible contamination:

<input type="checkbox"/> Septic Tank	<input type="checkbox"/> Lateral Lines	<input type="checkbox"/> Pit Privy	<input type="checkbox"/> Livestock Pens	<input type="checkbox"/> Insecticide Storage
<input type="checkbox"/> Sewer Lines	<input type="checkbox"/> Cess Pool	<input type="checkbox"/> Sewage Lagoon	<input type="checkbox"/> Fuel Storage	<input type="checkbox"/> Abandoned Water Well
<input type="checkbox"/> Watertight Sewer Lines	<input type="checkbox"/> Seepage Pit	<input type="checkbox"/> Feedyard	<input type="checkbox"/> Fertilizer Storage	<input type="checkbox"/> Oil Well/Gas Well
<input type="checkbox"/> Other (Specify)				

Direction from well? Distance from well? ft.

10 FROM	TO	LITHOLOGIC LOG	FROM	TO	LITHO. LOG (cont.) or PLUGGING INTERVALS

Notes:

11 CONTRACTOR'S OR LANDOWNER'S CERTIFICATION: This water well was constructed, reconstructed, or plugged under my jurisdiction and was completed on (mo-day-year) and this record is true to the best of my knowledge and belief. Kansas Water Well Contractor's License No. This Water Well Record was completed on (mo-day-year) under the business name of

GULF EXPLORATION L.L.C.

July 23, 2015

Kansas Department of Health and Environment
Attn: Pamela Chaffee
1000 S.W. Jackson, Ste. 420
Topeka, Kansas 66612-1367


RE: Assignment of Water Well to Landowner
Lyman L. Goetsch
Section 3-7S-36W
Thomas County, Kansas

Dear Ms. Chaffee:

Enclosed please find the aforementioned executed Assignment of Water Well in the above mentioned lands.

Should you need anything further please do not hesitate to contact me at the number listed below.

Sincerely,

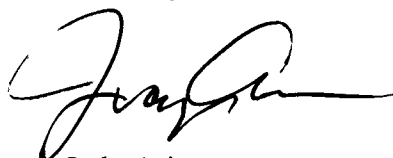

Judy Arias

Enc.

RECEIVED
JUL 27 2015
BUREAU OF WATER



ASSIGNMENT OF WATER WELL TO LANDOWNER

I, Lyman L. Goetsch of 2470 County Road 5
(Landowner's address)

Brewster, Kansas 67732 am the landowner on which a water well is located in
(City) (State)
the NE quarter of the NE quarter of the SE quarter in Section 3, Township 7S,
Range 36 ~~E/W~~, in Thomas County, Kansas which is approximately
2200 feet north/~~west~~ and 400 feet ~~east~~/west of the apparent SE/4 section
corner. The water well was drilled in May 2015 (month/year).

I hereby request that GULF EXPLORATION, L.L.C. leave the water well,
(Operator name)

which was drilled by Temporary Water Permit # 487665, unplugged, and I will
assume all responsibility for the plugging of said water well in accordance with the requirements
of the Kansas Department of Health and Environment regulation K.A.R. 28-30-7.

LANDOWNER:

Lyman L. Goetsch 7-15-15
(Signature) (Date)

Lyman L. Goetsch
(Print)

OPERATOR:

Pat McGraw 7/10/15
(Signature) (Date)

By: Pat McGraw
(Agent)

IF ADDITIONAL LANDOWNER

(Signature) (Date)

(Print)

RECEIVED
JUL 27 2015
BUREAU OF WATER